

3 GENERAL NOTES

2 COLOR SCHEDULE

| ITEM | COLOR OR VDC FILM | NOTES |
|------|----------------------------------|---|
| 1 | BM 2037-20 Jade Green | Existing sign color |
| 2 | BM 2032-10 Neon Green | Existing sign color |
| 3 | BM 2034-30 Grassy Fields | Existing sign color |
| 4 | BM 2155-10 Desert Sunset | Existing sign color |
| 5 | BM OC-117 Simply White | Existing sign color |
| 6 | Custom color TBD | |
| 7 | Custom color TBD | |
| 8 | Custom color TBD | |
| 9 | Gecko Green, Matthews Paint #469 | |
| 10 | Custom color TBD | |
| 11 | Custom color TBD | |
| 12 | Custom color TBD | |
| 13 | Custom color TBD | |
| 14 | Custom color TBD | |
| 15 | Custom film TBD | Vinyl to be 3M Scotchlite Cast Vinyl or 3M Scotchlite Reflective Vinyl Sheeting unless otherwise specified on drawings, 7 yr. outdoor durability minimum. |
| 16 | Custom film TBD | See above for info |
| 17 | Custom film TBD | See above for info |
| 18 | Custom film TBD | See above for info |
| 19 | Custom film TBD | See above for info |
| 20 | Custom color TBD | |
| 21 | Custom color TBD | |

ABDCDEFGHIJ
KLNOPQRSTU
VWXYZ abcd ef g
hijklmnoqrstuv
wxyz1234567890

A B D C D E F G H I J
K L N O P Q R S T U V
W X Y Z a b d c d e f g h
i j k l m n o q r s t u v w
x y z 1 2 3 4 5 6 7 8 9 0

A B C D E F G H I J
K L N O P Q R S T U V
W X Y Z a b c d e f g h
i j k l m n o p q r s t u v w
x y z 1 2 3 4 5 6 7 8 9 0

Georgia – classic and literary; the serif companion to Verdana. Used for signs not requiring raised characters and braille.

1 FONT NTS

GENERAL NOTES

All designs, ideas, arrangements and plans indicated by these drawings are the property and copyright of the Architect and shall neither be used on any other work nor be disclosed to any other person for any use whatsoever without written permission.

Koning Eizenberg Architecture and/or its principals and employees waives any and all liability or responsibility for problems that may occur when these plans, drawings, specifications, and/or designs are followed without the professional's guidance with ambiguities, or conflicts which are alleged.



7906 W. 4th St. Los Angeles, Ca 90048
323 658-7955 Fax 323 658-7961

NEW SOM
DESIGN
CONSULTANT



1437 4TH STREET, SUITE 300
SANTA MONICA, CA 90401
TEL. (310) 458-2205
FAX. (310) 399-1541
architecture@smgov.net

DATE: _____ 20____
SUBMITTED BY: _____

DATE : _____ 20 ____
APPROVED BY :
Miriam Mulder,
Architecture Services Manager

REVIEWED BY : DATE : _____ 20__

REVIEWED BY: DATE: _____ 20 ____

REVIEWED BY: DATE: _____ 20 ____

CITY CLIENT

| | | | |
|-----------|----------|----|--------------|
| | | | |
| | | | |
| | | | |
| | | | |
| 3 | 07/16/12 | | BULLETIN 1 |
| | 06/21/12 | | PLAN CHECK 2 |
| | 05/07/12 | | PLAN CHECK 1 |
| 2 | 03/06/12 | | ADDENDUM 3 |
| 1 | 02/21/12 | | ADDENDUM 2 |
| NO. | DATE | BY | DESCRIPTION |
| REVISIONS | | | |

ISSUE
100% CONSTRUCTION DOCUMENTS

DATE
06/21/2012


DRAWING NO. **6693**

SHEET TITLE

GENERAL NOTES

SHEET NO.

GO

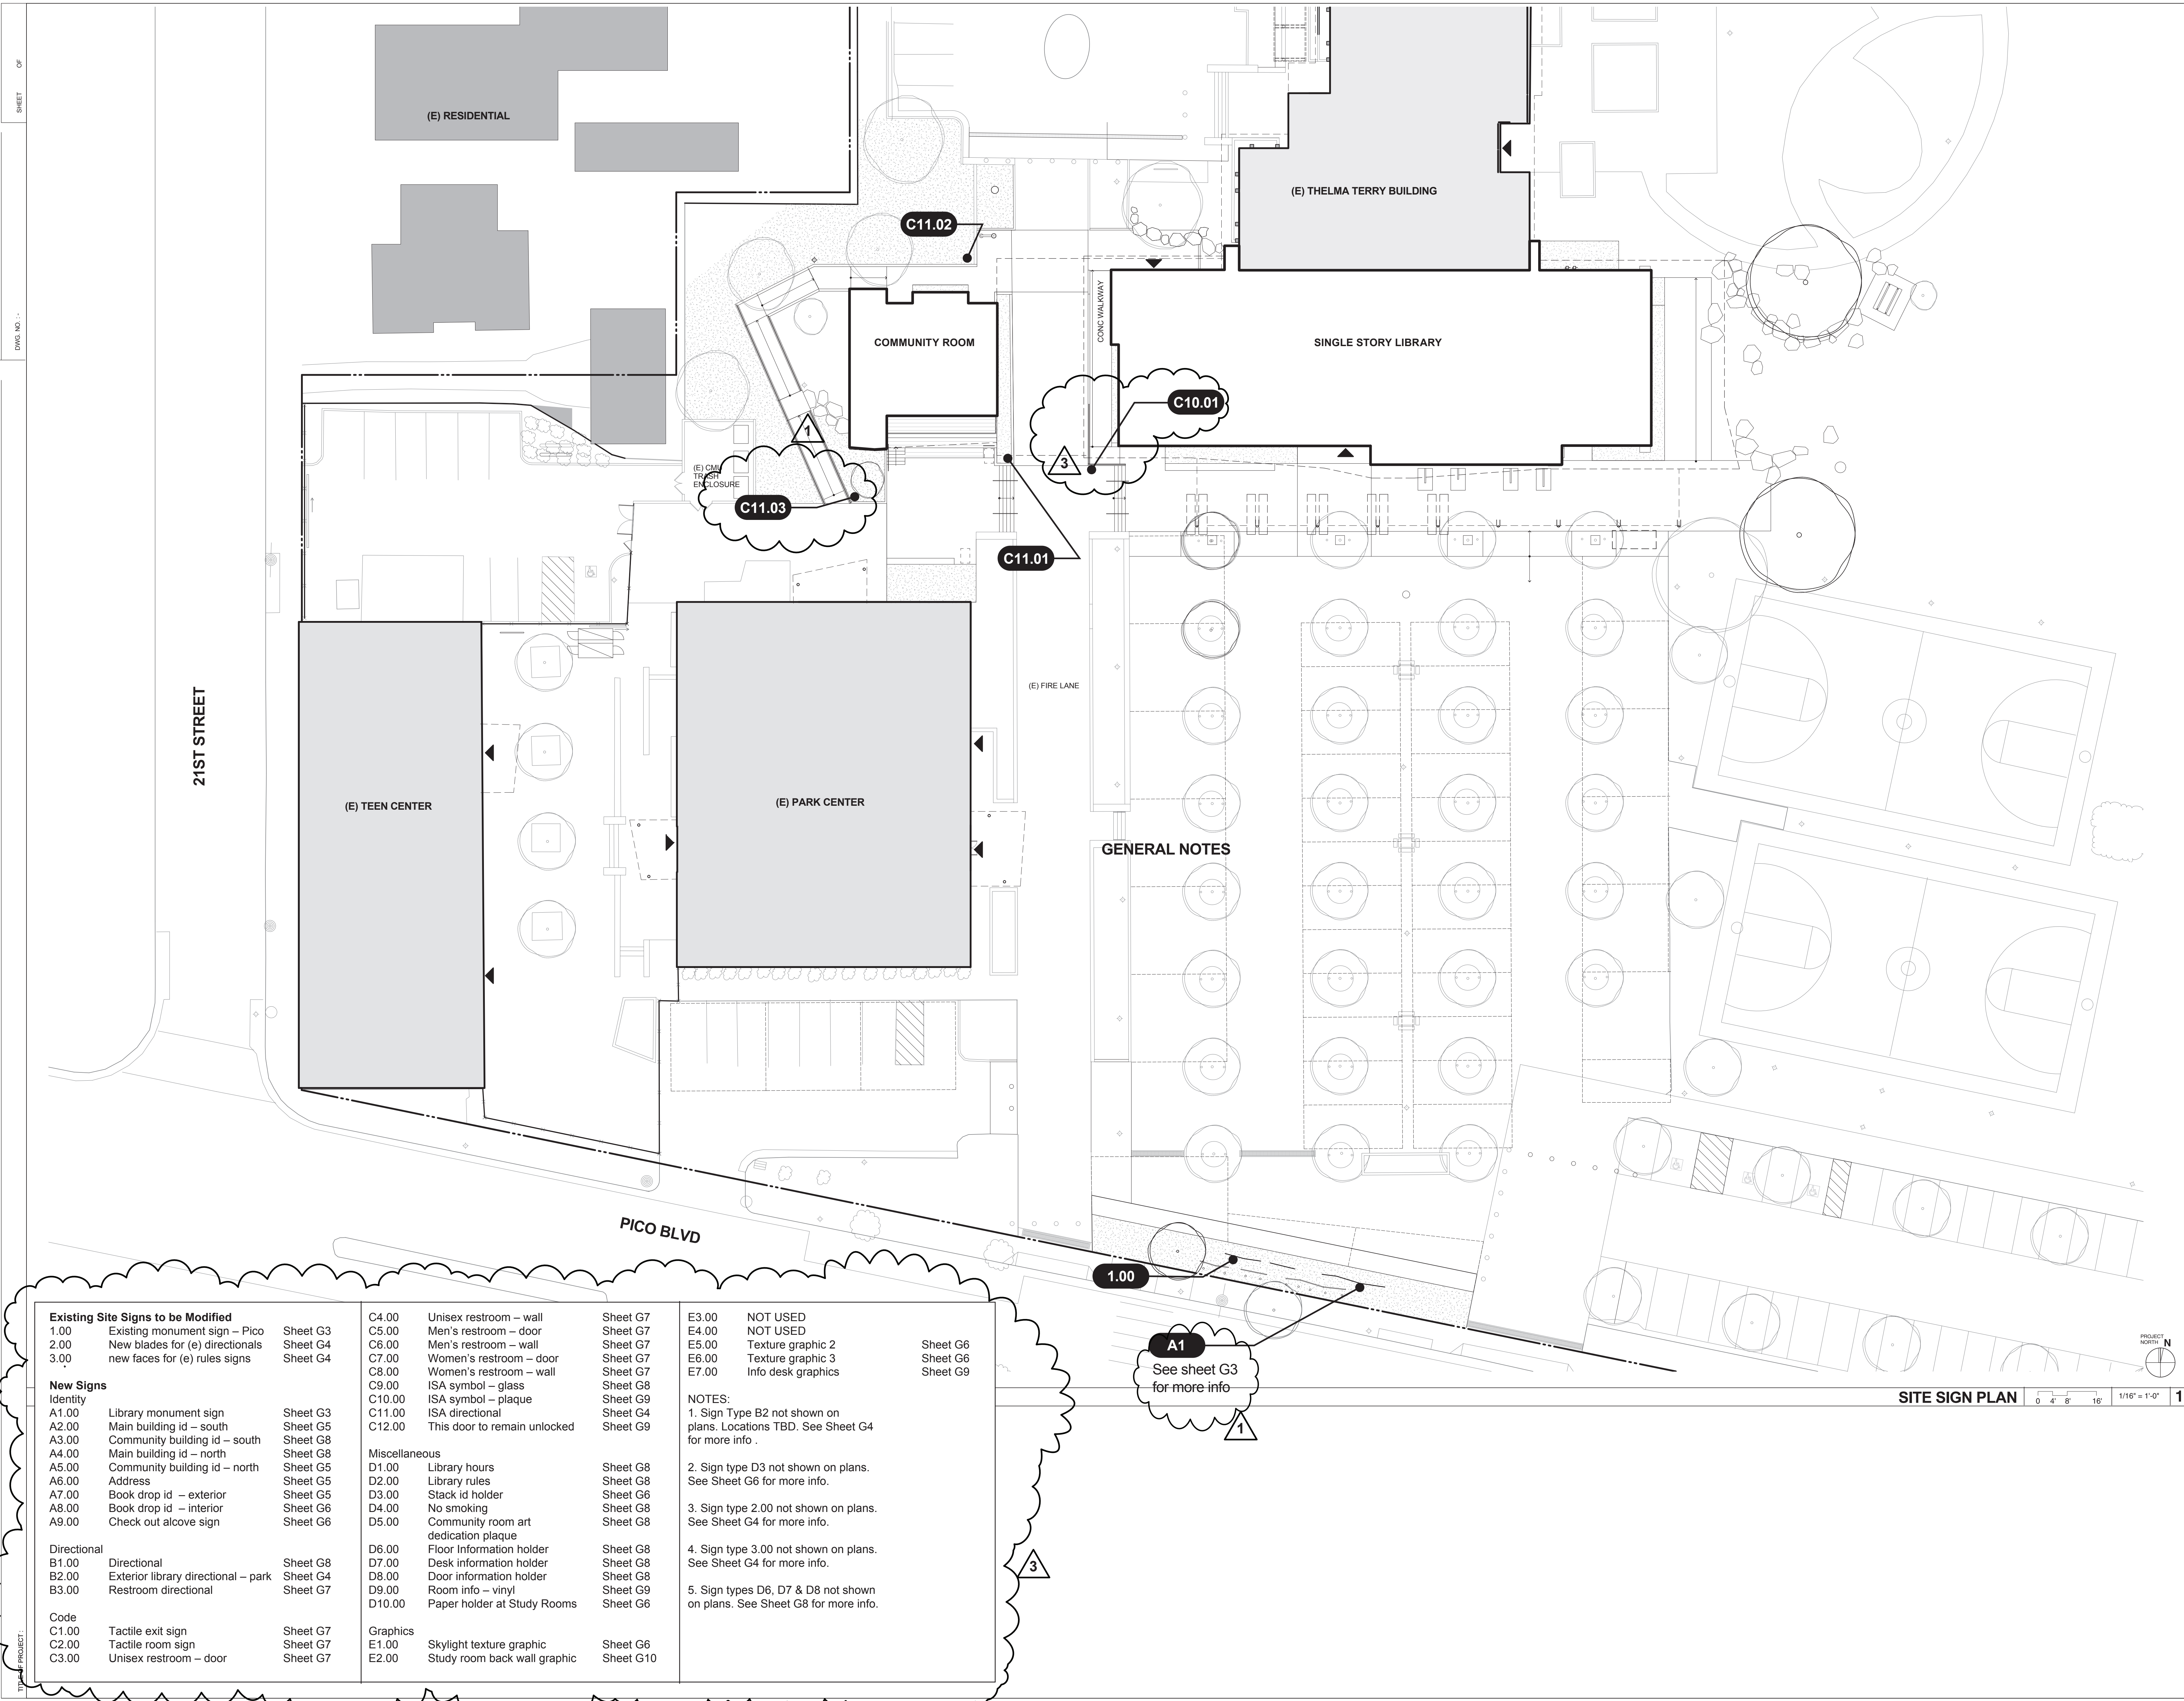

PICO BRANCH LIBRARY
2201 Pico Blvd.
Santa Monica, CA 90404

PROJECT
KoningEisenbergArchitecture
1454 29th St, Santa Monica, CA 90404
310.828.6131 info@kearch.com
310.828.0719 fax www.kearch.com

ARCHITECT'S PROJECT NO.
1001

ARCHITECT

All designs, ideas, arrangements and plans indicated by these drawings are the property and copyright of the Architect and shall neither be used on any other work nor be disclosed to any other person for any use whatsoever without written permission.

Koning Eisenberg Architecture and/or its principals and employees waives any and all liability or responsibility for problems that may occur when these plans, drawings, specifications, and/or designs are followed without the professional's guidance with ambiguities, or conflicts which are alleged.



7906 W. 4th St. Los Angeles, Ca 90048
323 658-7955 Fax 323 658-7961

NEWSOM
DESIGN

CONSULTANT
City of Santa Monica
Architecture Services

1437 4TH STREET, SUITE 300
SANTA MONICA, CA 90401
TEL. (310) 456-2205
FAX. (310) 399-1541
architecture@smgov.net

DATE: ____ 20 ____
SUBMITTED BY: _____

DATE: ____ 20 ____
APPROVED BY: _____
Miriam Mulder
Architecture Services Manager

CITY OF SANTA MONICA
DEPARTMENT OF PUBLIC WORKS

REVIEWED BY: DATE: ____ 20 ____

REVIEWED BY: DATE: ____ 20 ____

REVIEWED BY: DATE: ____ 20 ____

CITY CLIENT

| NO. | DATE | BY | DESCRIPTION |
|-----------|------|----|--------------|
| 07/16/12 | | | BULLETIN 1 |
| 06/21/12 | | | PLAN CHECK 2 |
| 05/07/12 | | | PLAN CHECK 1 |
| 03/06/12 | | | ADDENDUM 3 |
| 02/21/12 | | | ADDENDUM 2 |
| REVISIONS | | | |


ISSUE
100% CONSTRUCTION DOCUMENTS

DATE
06/21/2012
DRAWING NO. **6693**

SHEET TITLE

SITE SIGN PLAN

SHEET NO.
G1

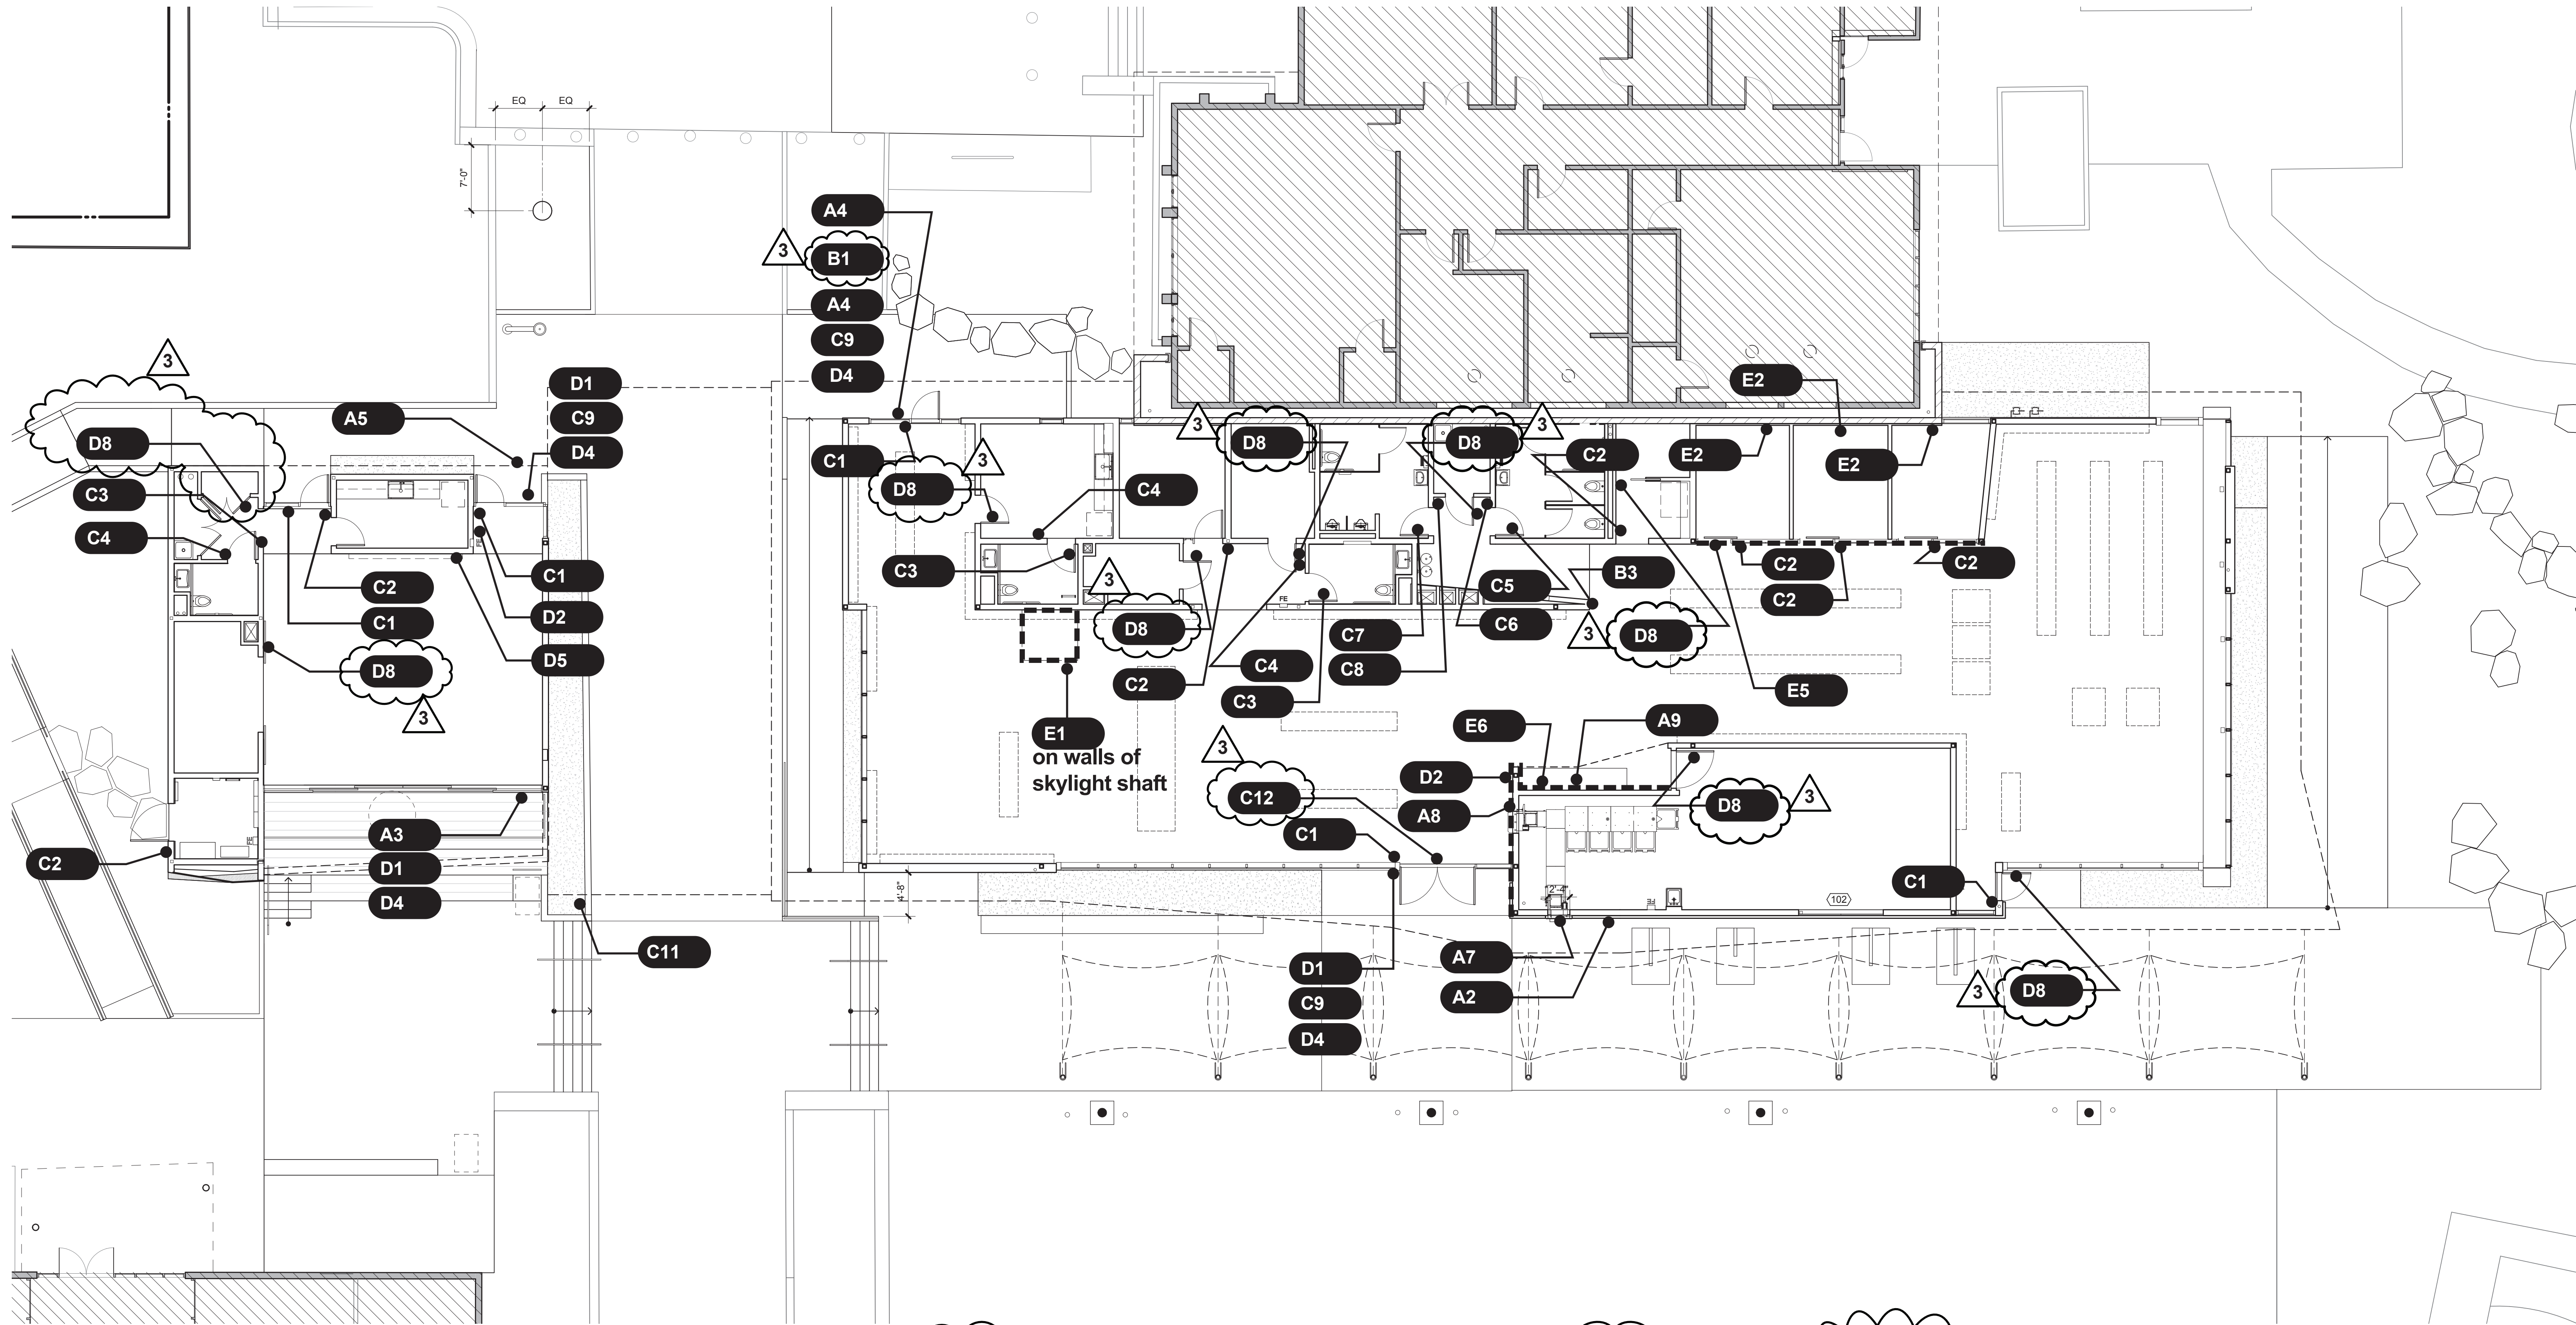**Existing Site Signs to be Modified**

| | | |
|------|---------------------------------|----------|
| 1.00 | Existing monument sign – Pico | Sheet G3 |
| 2.00 | New blades for (e) directionals | Sheet G4 |
| 3.00 | new faces for (e) rules signs | Sheet G4 |

New Signs

| | | |
|-------|-------------------------------|----------|
| A1.00 | Library monument sign | Sheet G3 |
| A2.00 | Main building id – south | Sheet G5 |
| A3.00 | Community building id – south | Sheet G8 |
| A4.00 | Main building id – north | Sheet G8 |
| A5.00 | Community building id – north | Sheet G5 |
| A6.00 | Address | Sheet G5 |
| A7.00 | Book drop id – exterior | Sheet G5 |
| A8.00 | Book drop id – interior | Sheet G6 |
| A9.00 | Check out alcove sign | Sheet G6 |

Directional

| | | |
|-------|-------------------------------------|----------|
| B1.00 | Directional | Sheet G8 |
| B2.00 | Exterior library directional – park | Sheet G4 |
| B3.00 | Restroom directional | Sheet G7 |

Code

| | | |
|-------|------------------------|----------|
| C1.00 | Tactile exit sign | Sheet G7 |
| C2.00 | Tactile room sign | Sheet G7 |
| C3.00 | Unisex restroom – door | Sheet G7 |

| | | |
|--------|------------------------------|----------|
| C4.00 | Unisex restroom – wall | Sheet G7 |
| C5.00 | Men's restroom – door | Sheet G7 |
| C6.00 | Men's restroom – wall | Sheet G7 |
| C7.00 | Women's restroom – door | Sheet G7 |
| C8.00 | Women's restroom – wall | Sheet G7 |
| C9.00 | ISA symbol – glass | Sheet G8 |
| C10.00 | ISA symbol – plaque | Sheet G9 |
| C11.00 | ISA directional | Sheet G4 |
| C12.00 | This door to remain unlocked | Sheet G9 |

Miscellaneous

| | | |
|--------|--------------------------------------|----------|
| D1.00 | Library hours | Sheet G8 |
| D2.00 | Library rules | Sheet G8 |
| D3.00 | Stack id holder | Sheet G6 |
| D4.00 | No smoking | Sheet G8 |
| D5.00 | Community room art dedication plaque | Sheet G8 |
| D6.00 | Floor Information holder | Sheet G8 |
| D7.00 | Desk information holder | Sheet G8 |
| D8.00 | Door information holder | Sheet G8 |
| D9.00 | Room info – vinyl | Sheet G9 |
| D10.00 | Paper holder at Study Rooms | Sheet G6 |

Graphics

| | | |
|-------|------------------------------|-----------|
| E1.00 | Skylight texture graphic | Sheet G6 |
| E2.00 | Study room back wall graphic | Sheet G10 |

| | | |
|-------|--------------------|----------|
| E3.00 | NOT USED | |
| E4.00 | NOT USED | |
| E5.00 | Texture graphic 2 | Sheet G6 |
| E6.00 | Texture graphic 3 | Sheet G6 |
| E7.00 | Info desk graphics | Sheet G9 |

NOTES:

1. Sign Type B2 not shown on plans. Locations TBD. See Sheet G4 for more info.
2. Sign type D3 not shown on plans. See Sheet G6 for more info.
3. Sign type 2.00 not shown on plans. See Sheet G4 for more info.
4. Sign type 3.00 not shown on plans. See Sheet G4 for more info.
5. Sign types D6, D7 & D8 not shown on plans. See Sheet G8 for more info.

SIGN PLAN

0 2' 4' 8' 1/8" = 1'-0"

PICO BRANCH LIBRARY2201 Pico Blvd.
Santa Monica, CA 90404**PROJECT**

KoningEisenbergArchitecture
1454 29th St. Santa Monica, CA 90404
310.828.6131 info@kearch.com
310.828.0719 fax www.kearch.com

ARCHITECT'S PROJECT NO.

1001**ARCHITECT**

All designs, ideas, arrangements and plans indicated by these drawings are the property and copyright of the Architect and shall neither be used on any other work nor be disclosed to any other person for any use whatsoever without written permission.

Koning Eisenberg Architecture and/or its principals and employees waives any and all liability or responsibility for problems that may occur when these plans, drawings, specifications, and/or designs are followed without the professional's guidance with ambiguities, or conflicts which are alleged.

7906 W. 4th St. Los Angeles, Ca 90048
323.658.7955 Fax 323.658.7961**NEW SOM
DESIGN****CONSULTANT**

1437 4TH STREET, SUITE 300
SANTA MONICA, CA 90401
TEL: (310) 456-2205
FAX: (310) 399-1541
architecture@smgov.net

DATE: 20

SUBMITTED BY:

DATE: 20

APPROVED BY:
Miriam Mulder
Architecture Services ManagerCITY OF SANTA MONICA
DEPARTMENT OF PUBLIC WORKS

REVIEWED BY: DATE: 20

REVIEWED BY: DATE: 20

REVIEWED BY: DATE: 20

CITY CLIENT

| NO. | DATE | BY | DESCRIPTION |
|-----|----------|----|--------------|
| 1 | 07/16/12 | | BULLETIN 1 |
| 2 | 06/21/12 | | PLAN CHECK 2 |
| 3 | 05/07/12 | | PLAN CHECK 1 |
| 4 | 03/06/12 | | ADDENDUM 3 |
| 5 | 02/21/12 | | ADDENDUM 2 |

REVISIONS**ISSUE****100% CONSTRUCTION DOCUMENTS**

DATE:

06/21/2012


DRAWING NO. **6693**

SHEET TITLE:

SIGN PLAN

SHEET NO.


G2**SIGN PLAN**

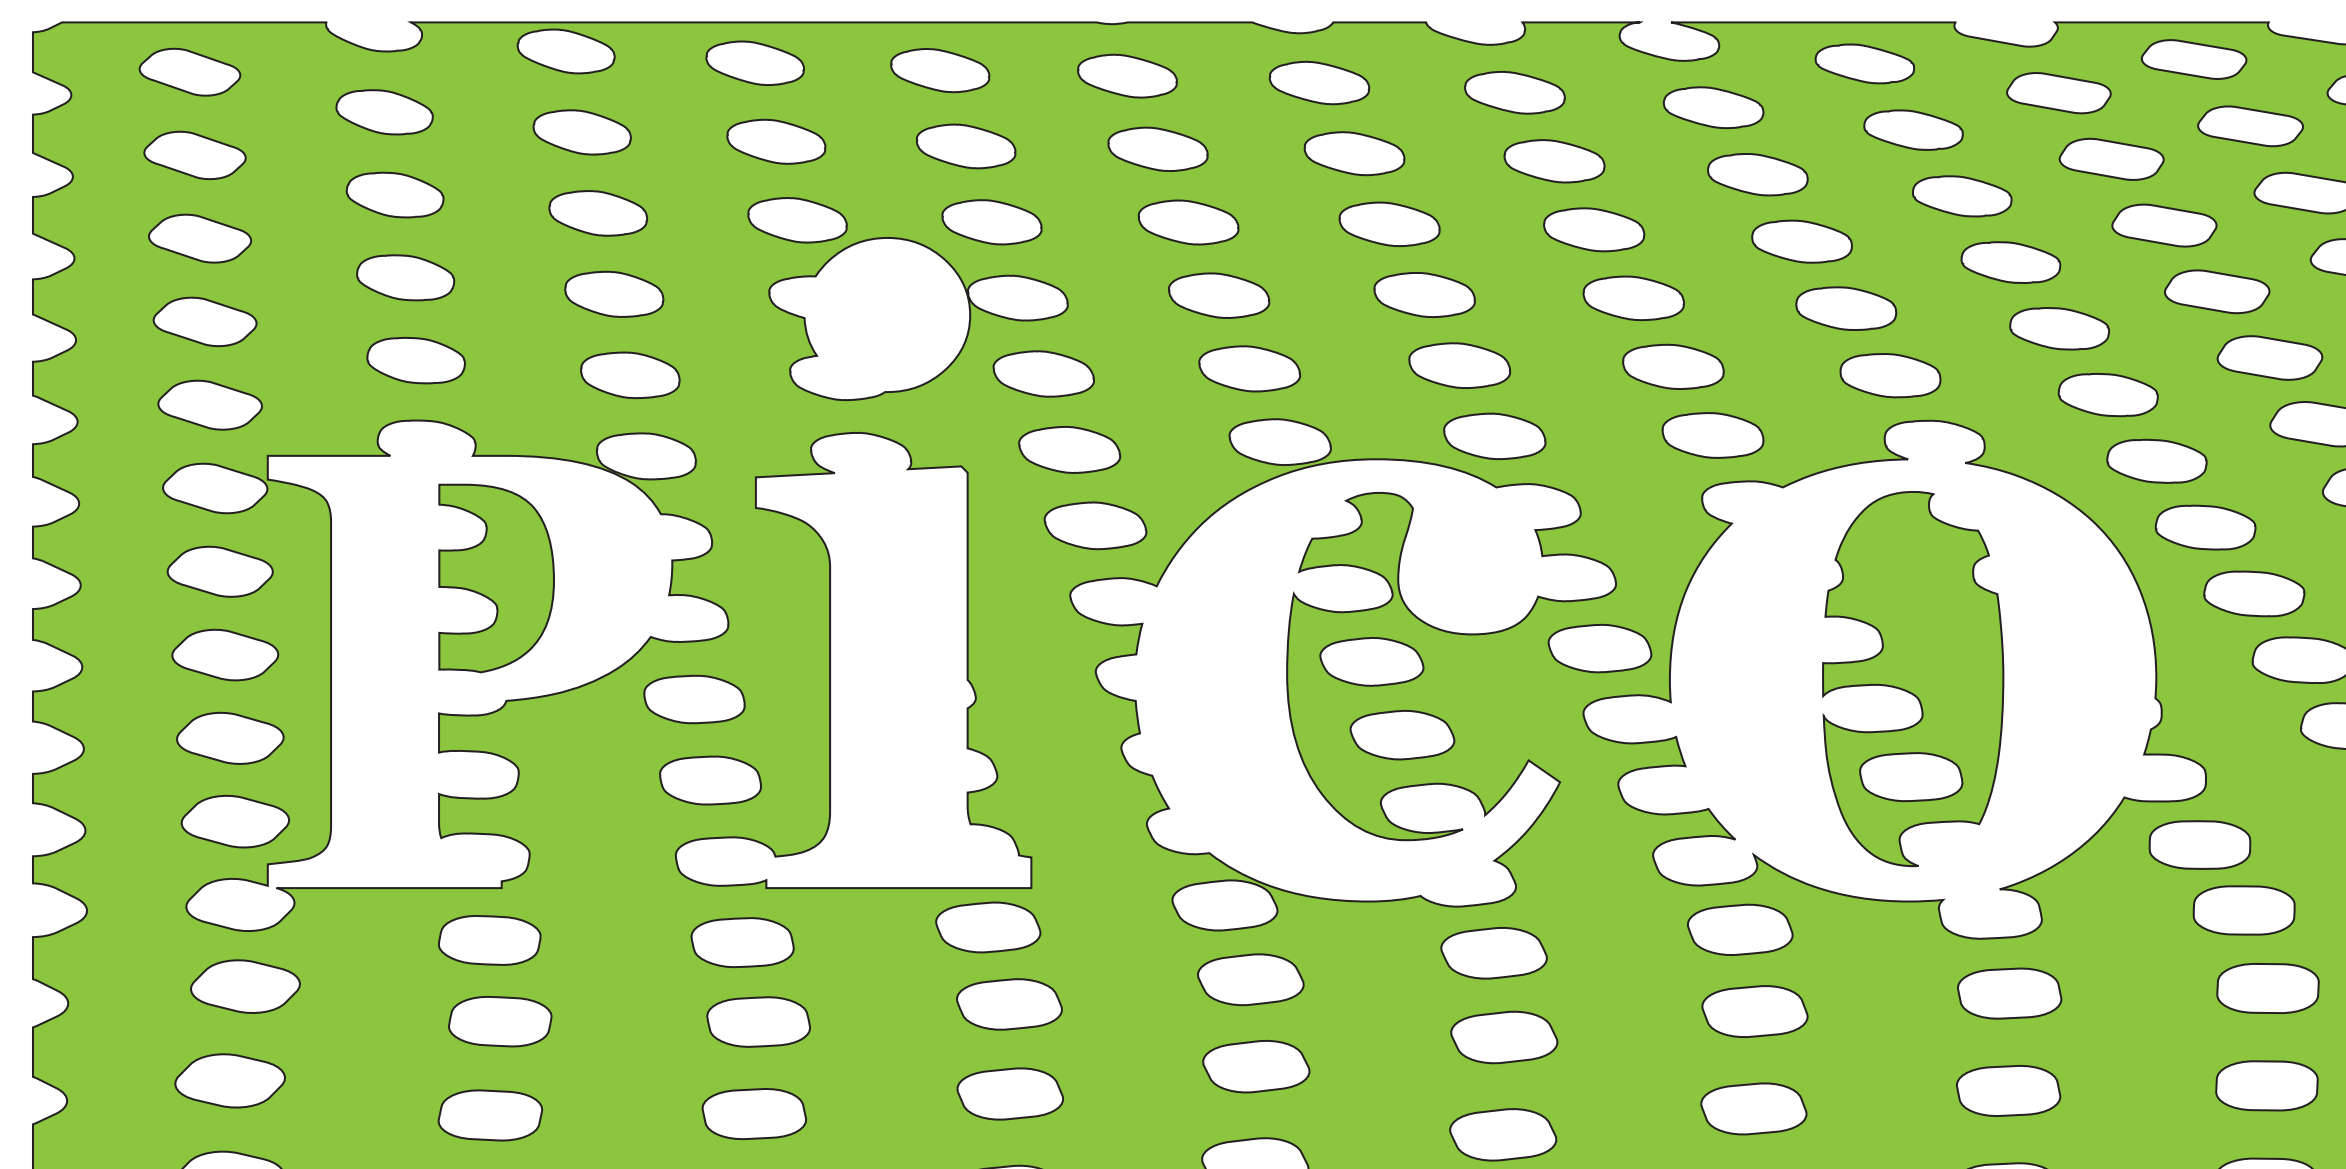


The elevation drawing shows the following details:

- Virginia Avenue Park Sign:**
 - Section 1 (Left): 3'-0" +/-, color 4, triangle 3.
 - Section 2 (Right): 5'-0" +/-, color 4, triangle 3.
- Pico Branch Library Sign:**
 - Section 1 (Left): 4'-1" +/-, color 8, triangle 3.
 - Section 2 (Middle): 6'-7" +/-, color 7, triangle 3.
 - Section 3 (Right): 7'-1" +/-, color 7, triangle 3.
- Dimensions:**
 - Height of the signs: 48" +/-.
- Color Codes:**
 - color 4: Orange background.
 - color 8: Green background with white dots.
 - color 7: Green background with white dots.
- Triangle 3:** A small triangle with the number 3 inside, indicating a specific color or material.

Colors: 1 custom color for panel, legs and fasteners.1 custom color for letters.

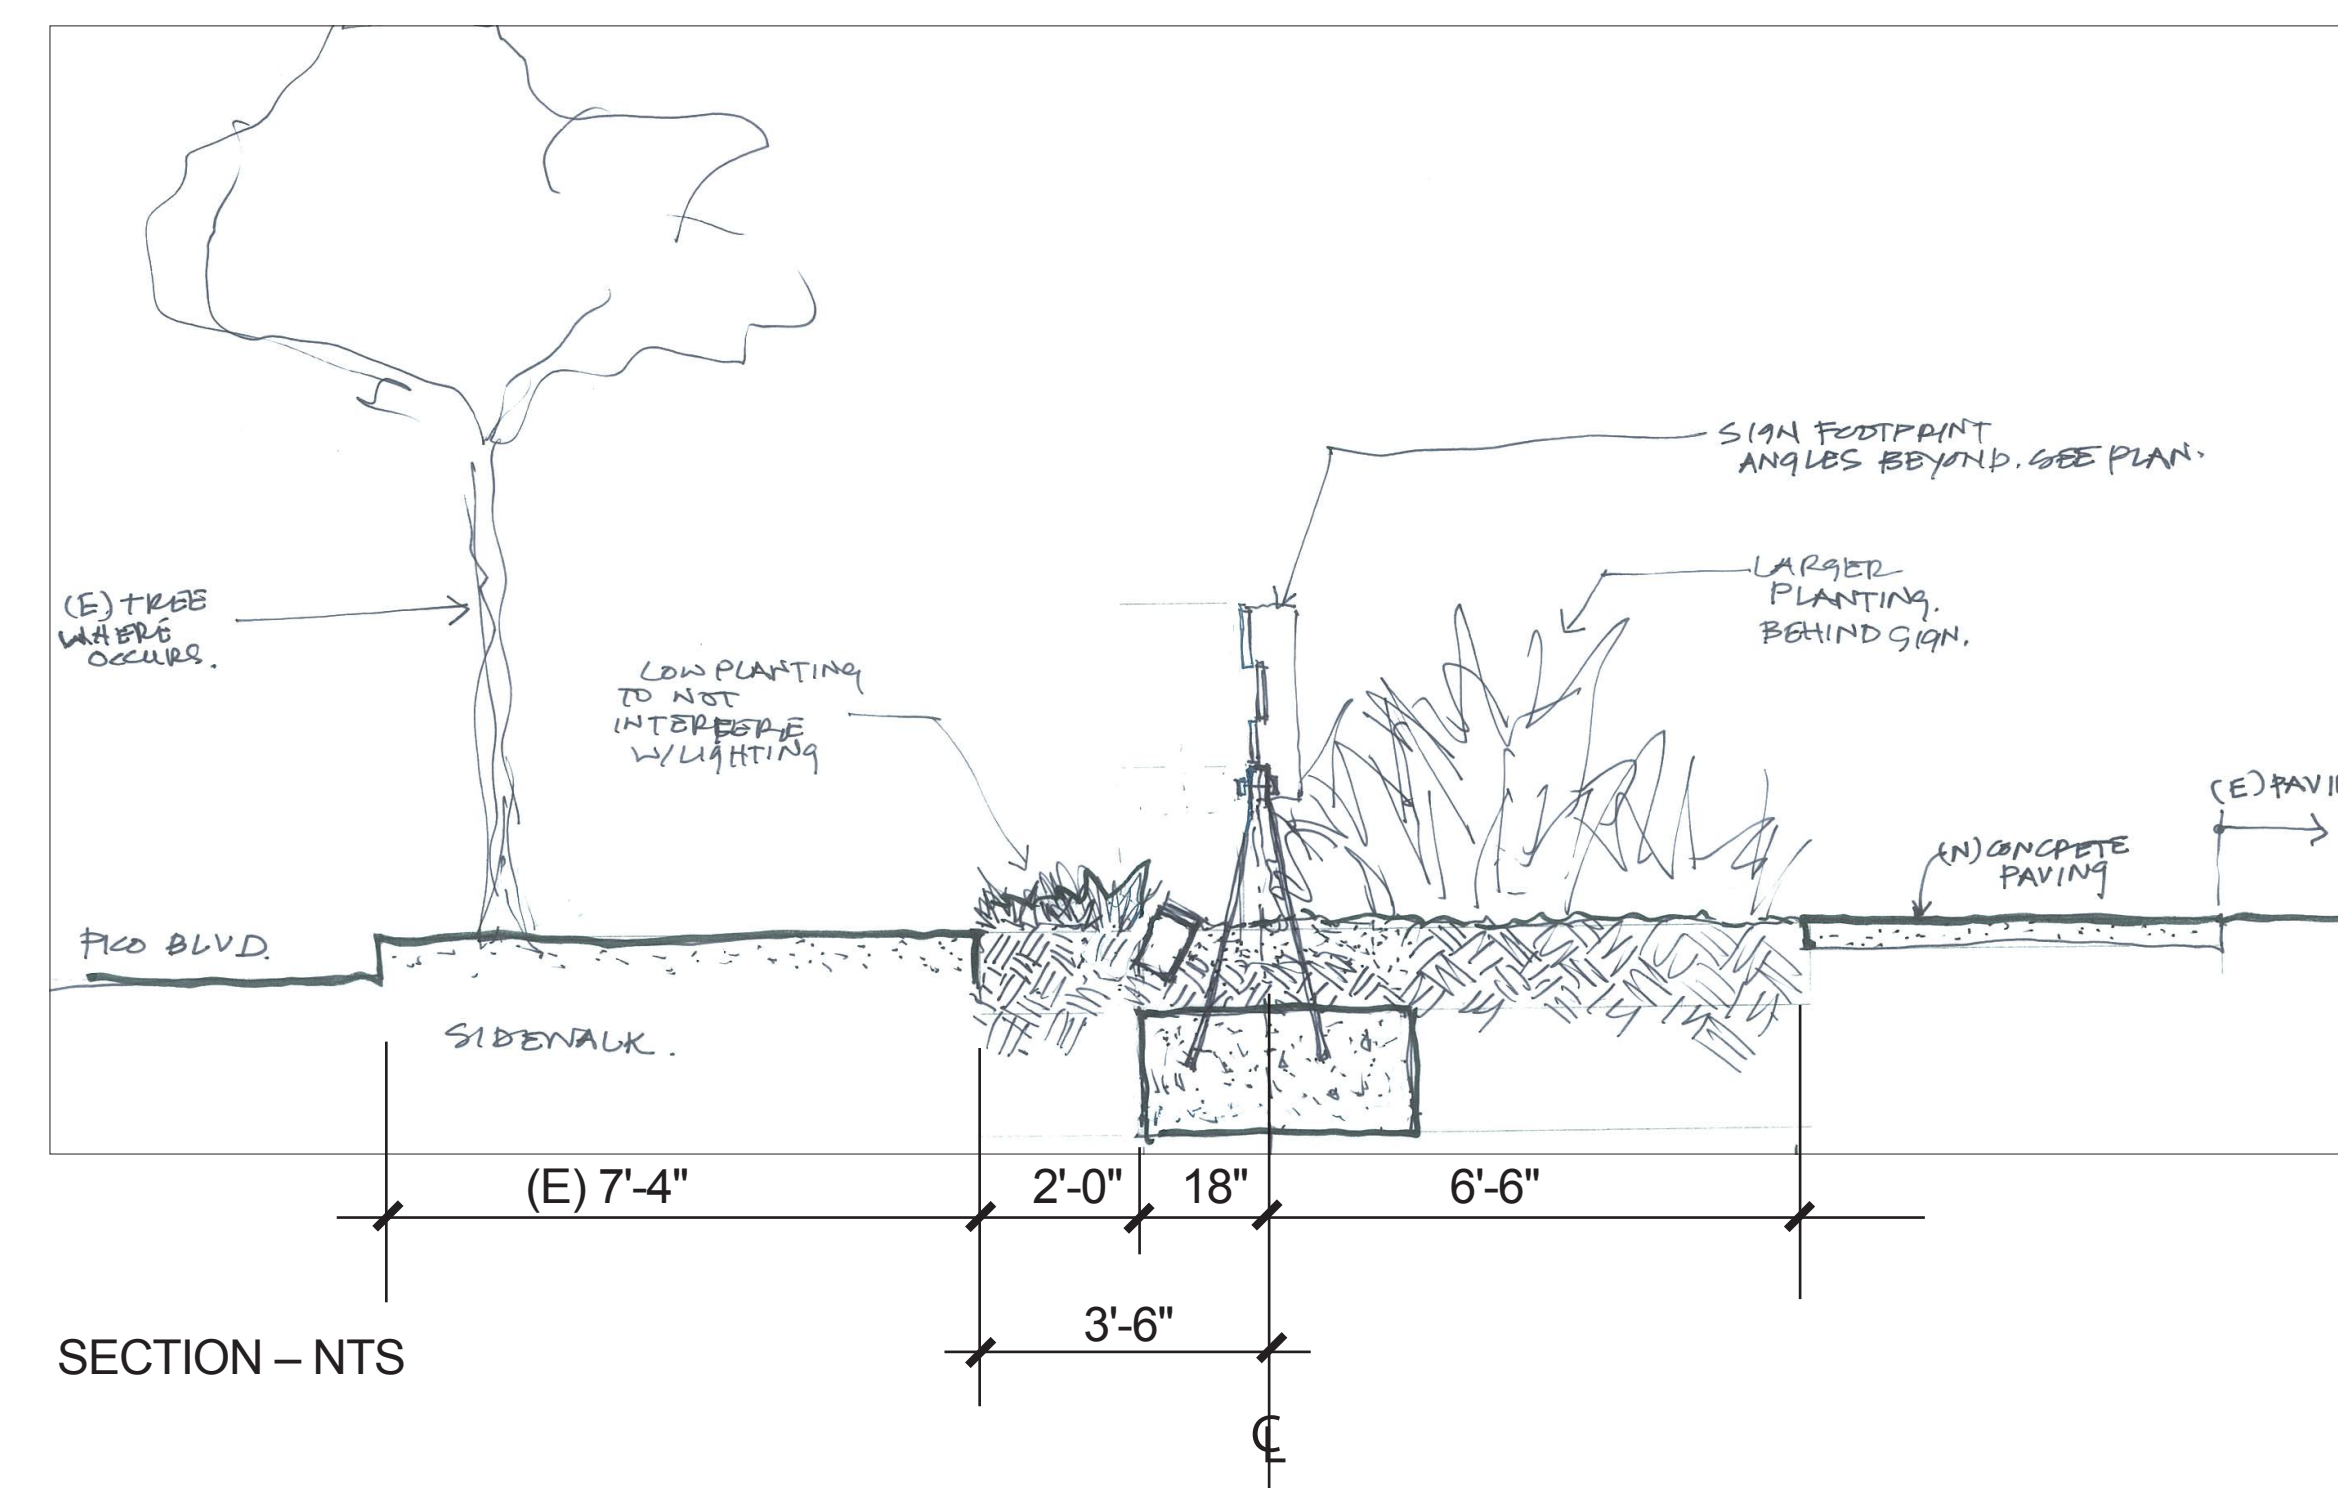

SECTION – NTS

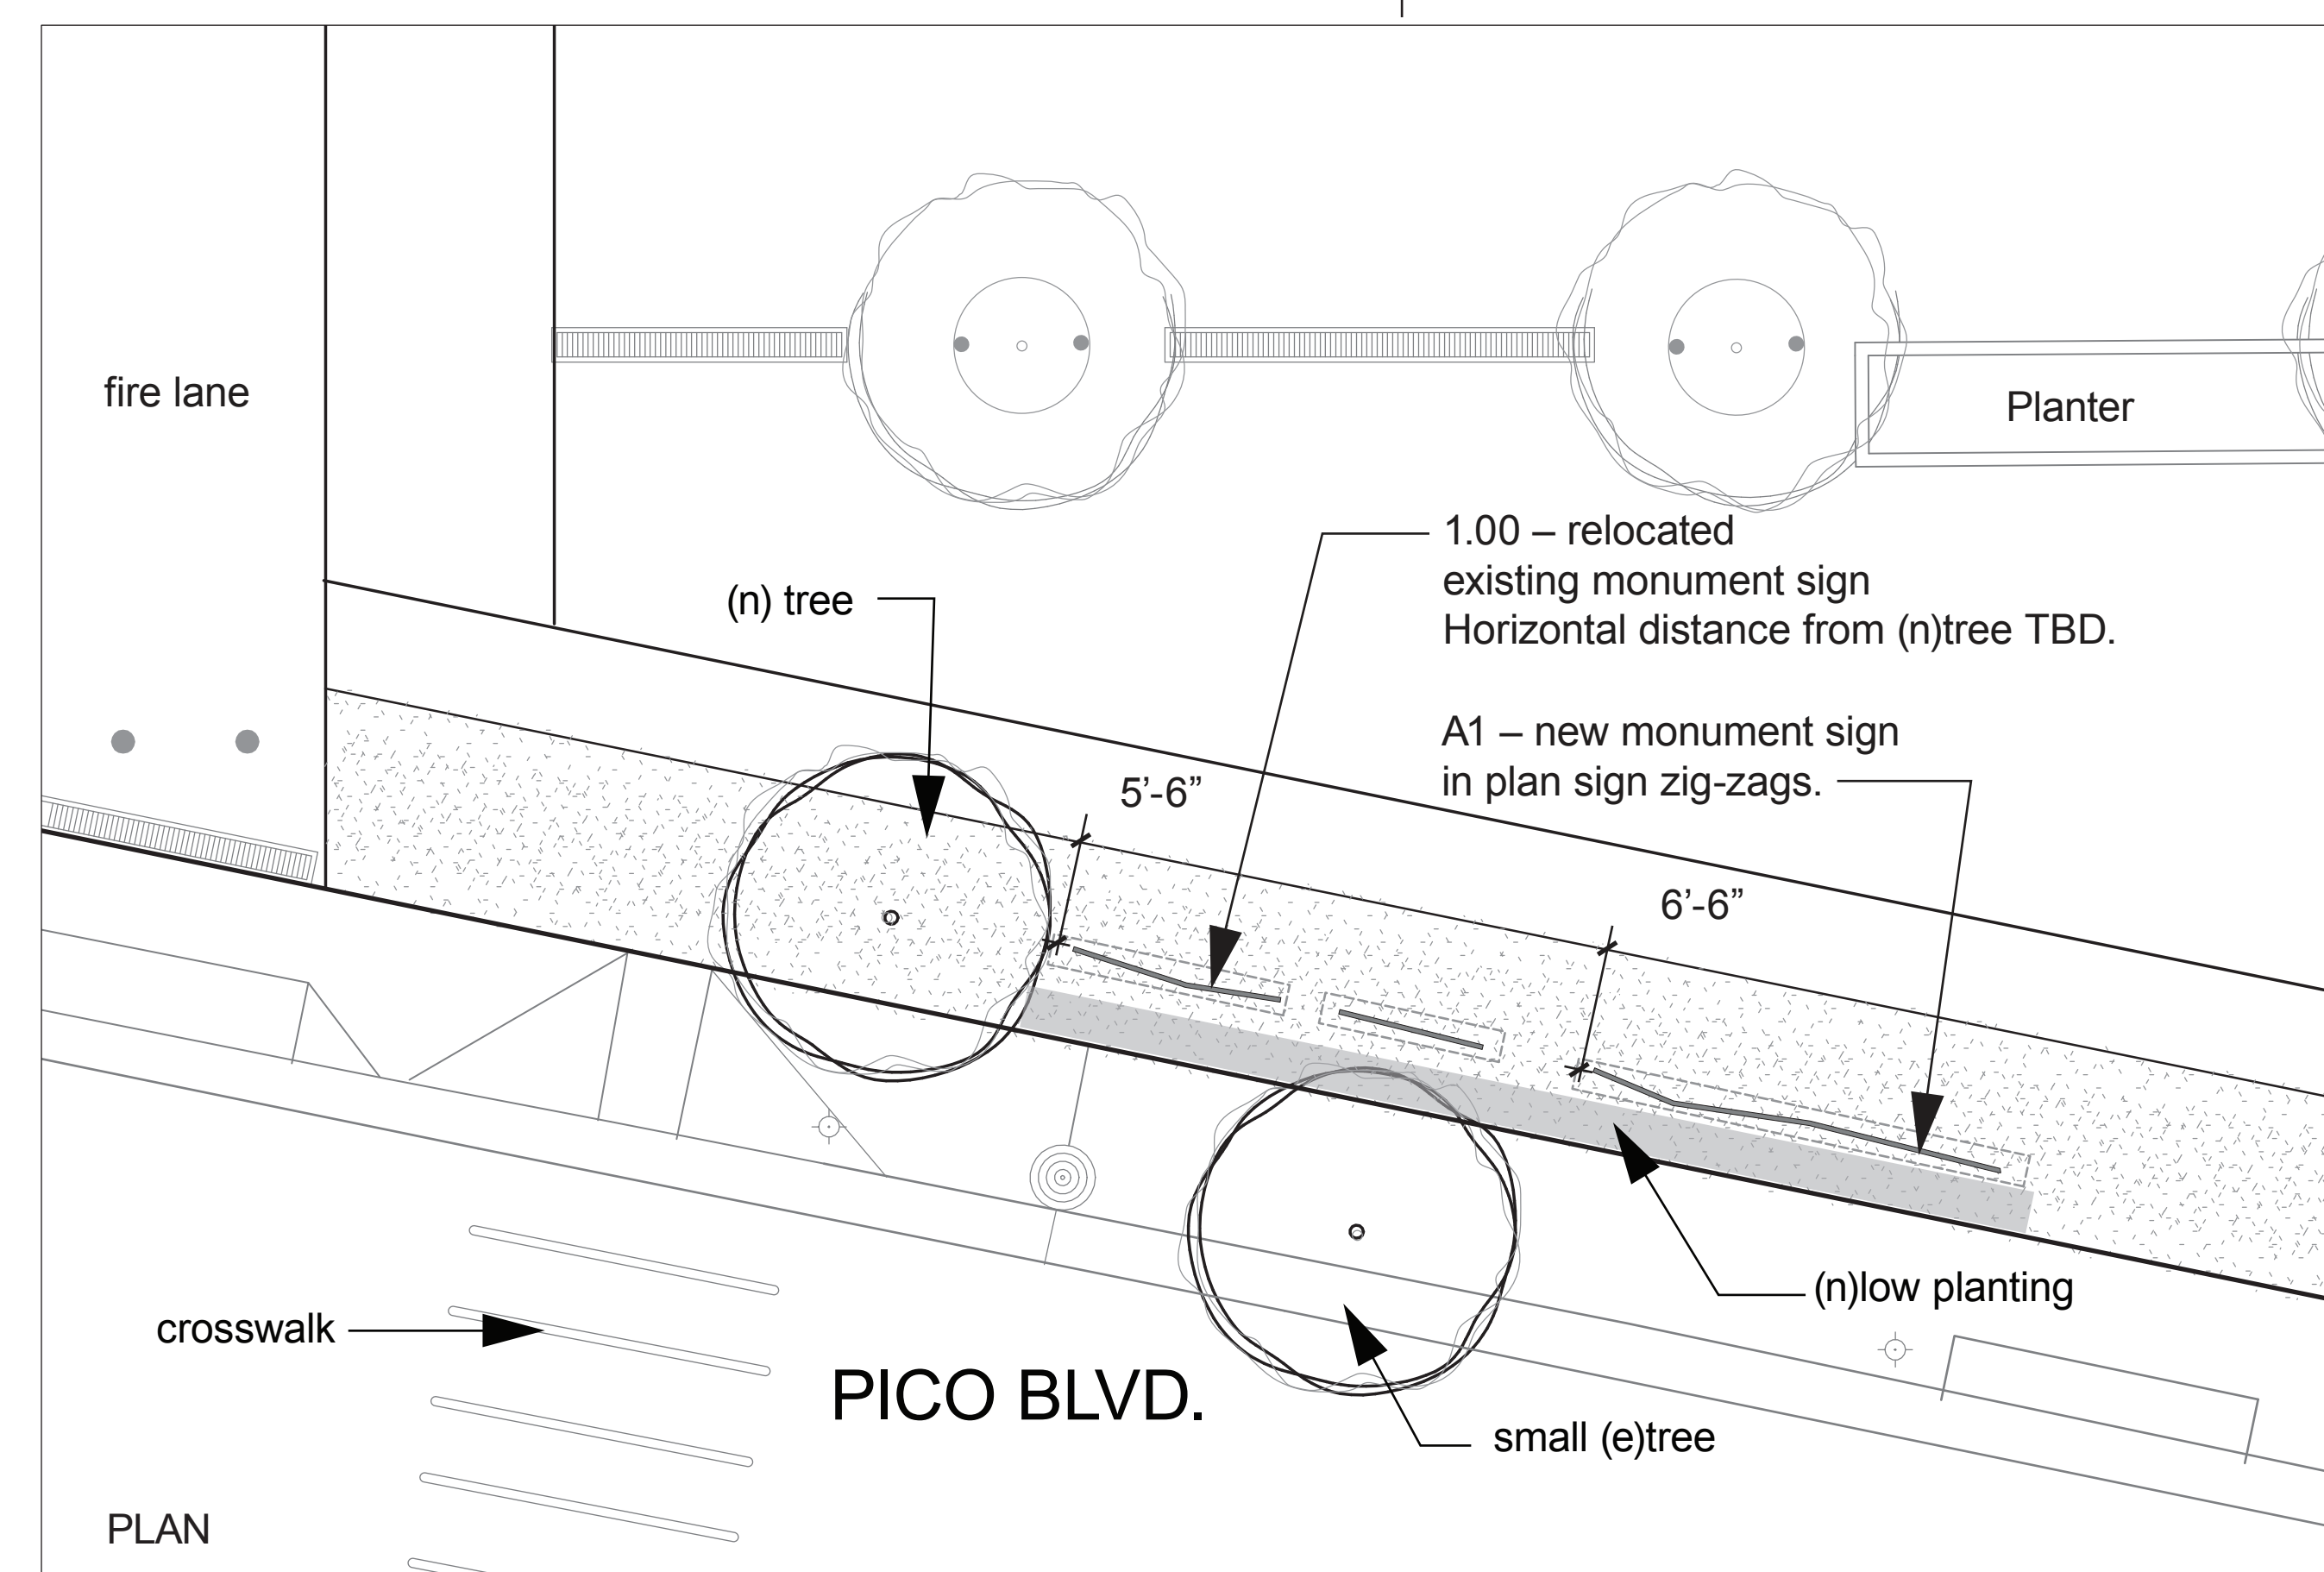


PLAN




| | | | |
|-----|----------|----|--------------|
| | | | |
| | | | |
| 3 | 07/16/12 | | BULLETIN 1 |
| | 06/21/12 | | PLAN CHECK 2 |
| | 05/07/12 | | PLAN CHECK 1 |
| 2 | 03/06/12 | | ADDENDUM 3 |
| 1 | 02/21/12 | | ADDENDUM 2 |
| NO. | DATE | BY | DESCRIPTION |

REVISIONS

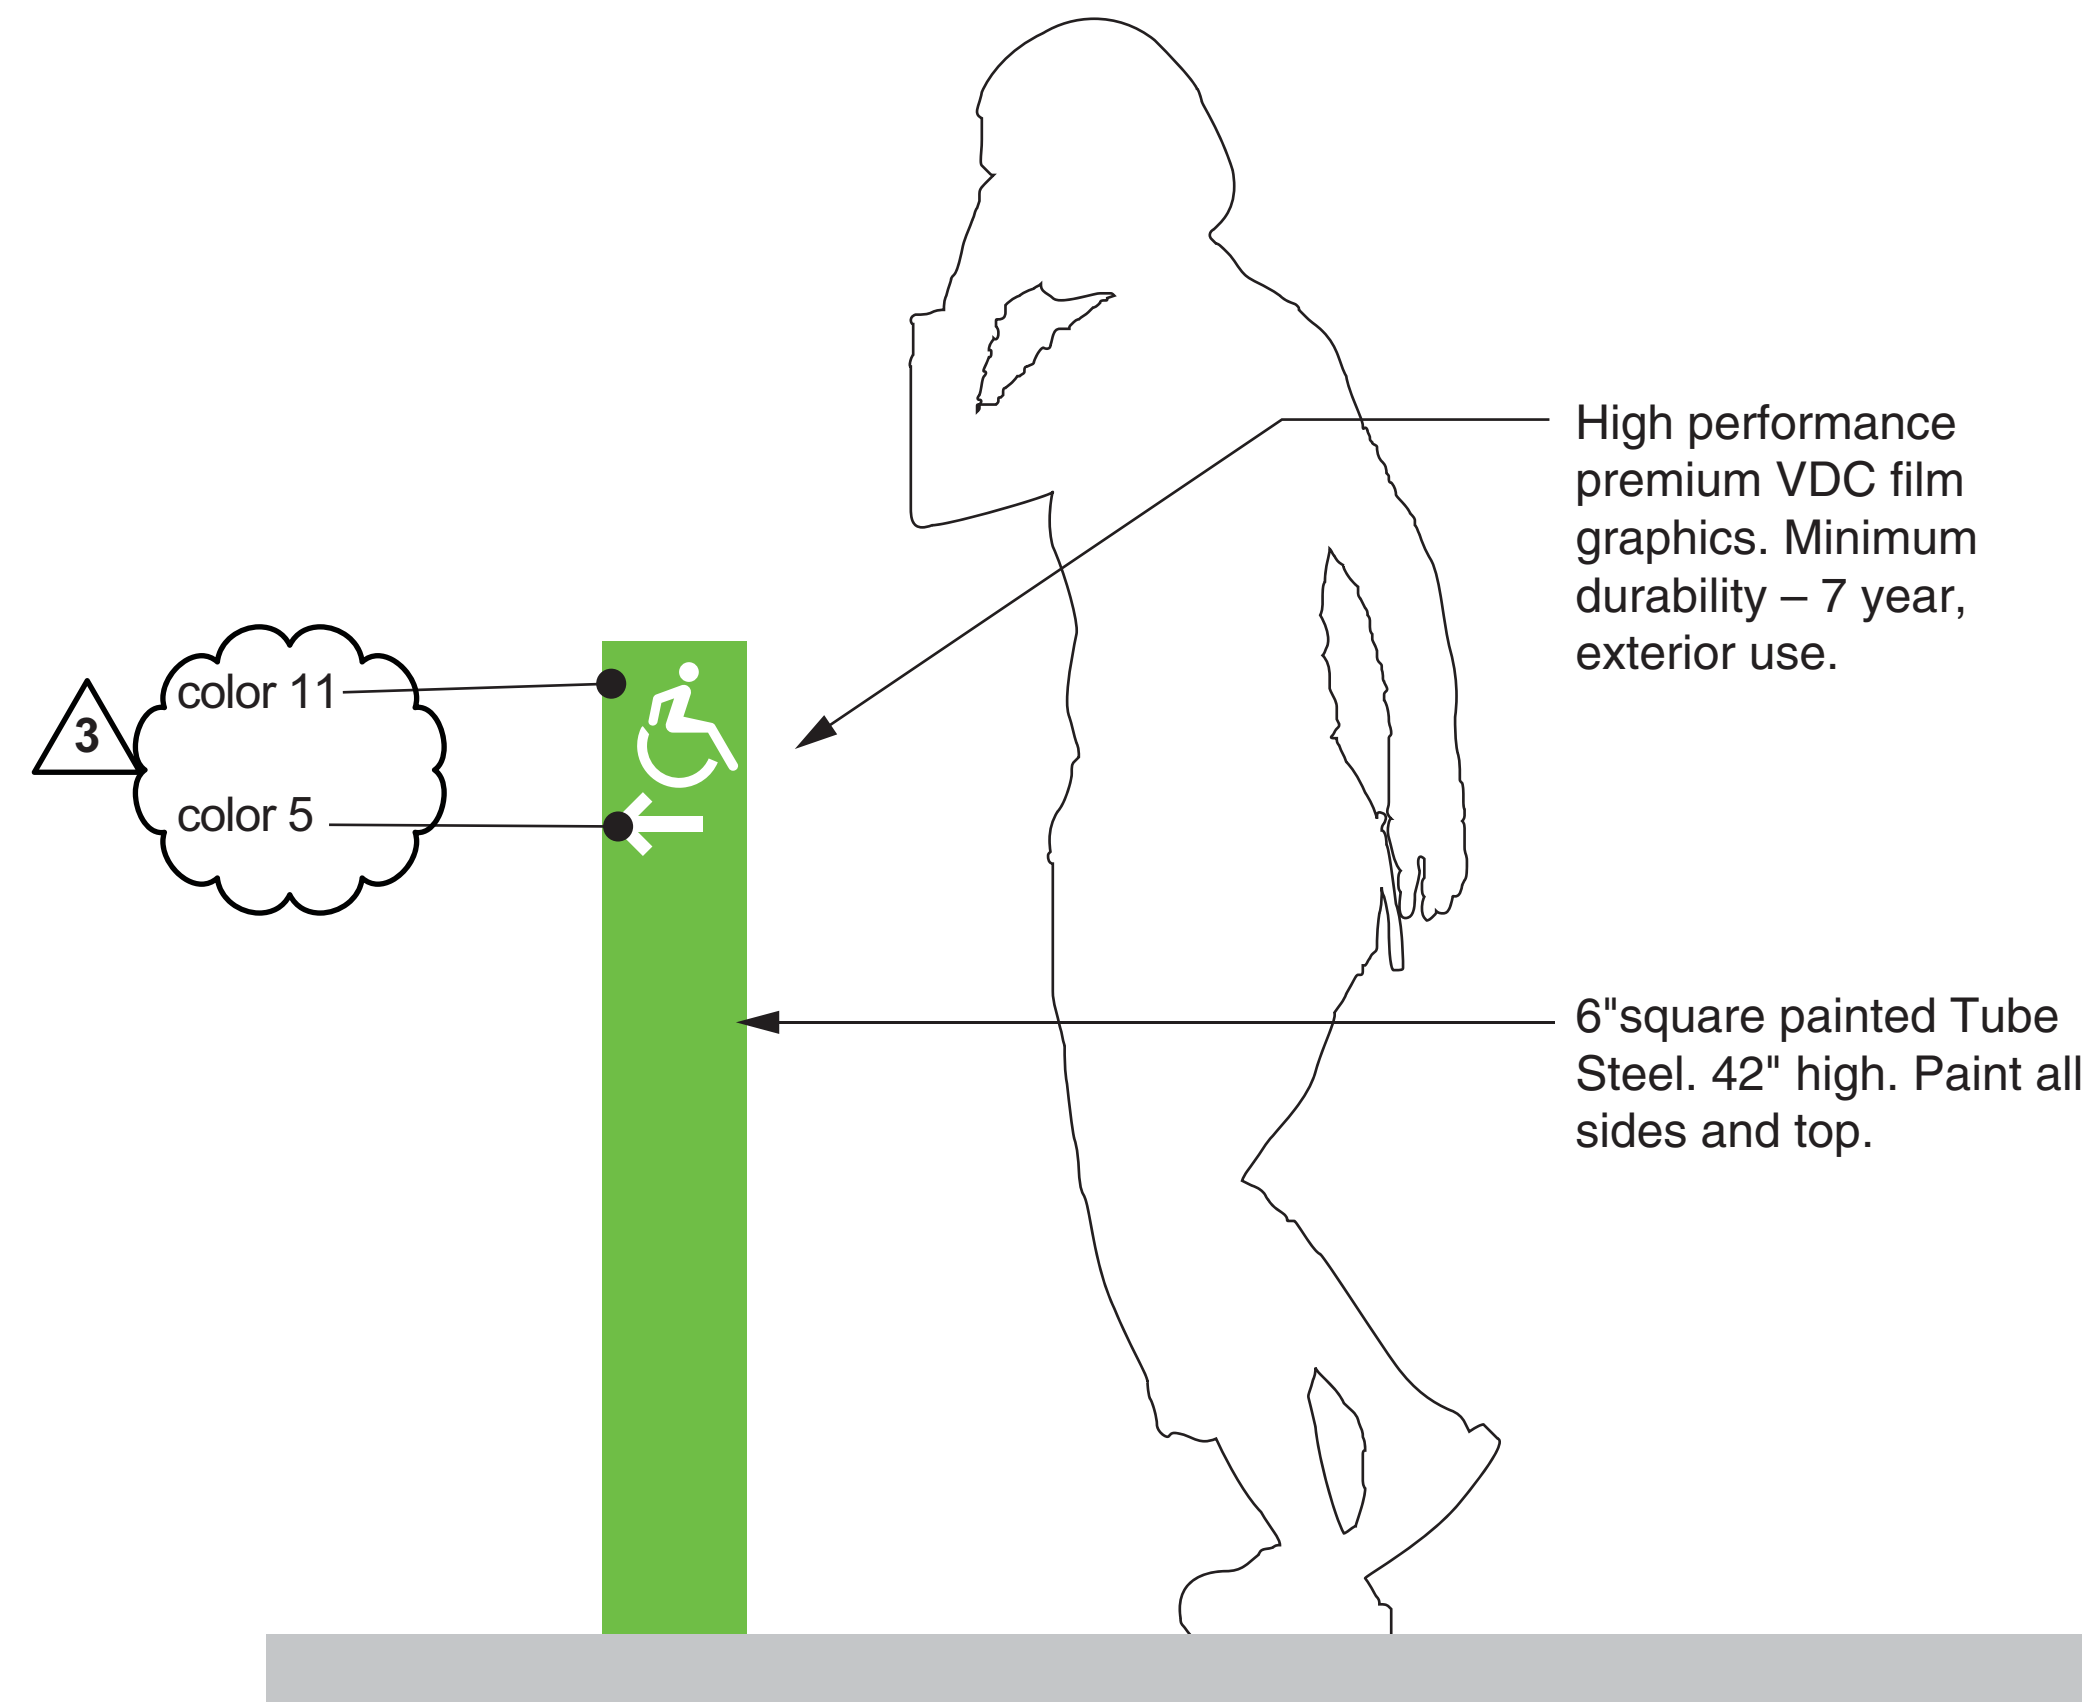

4 SIGN TYPE C11: ISA DIRECTIONAL

1 1/2"=1'-0"

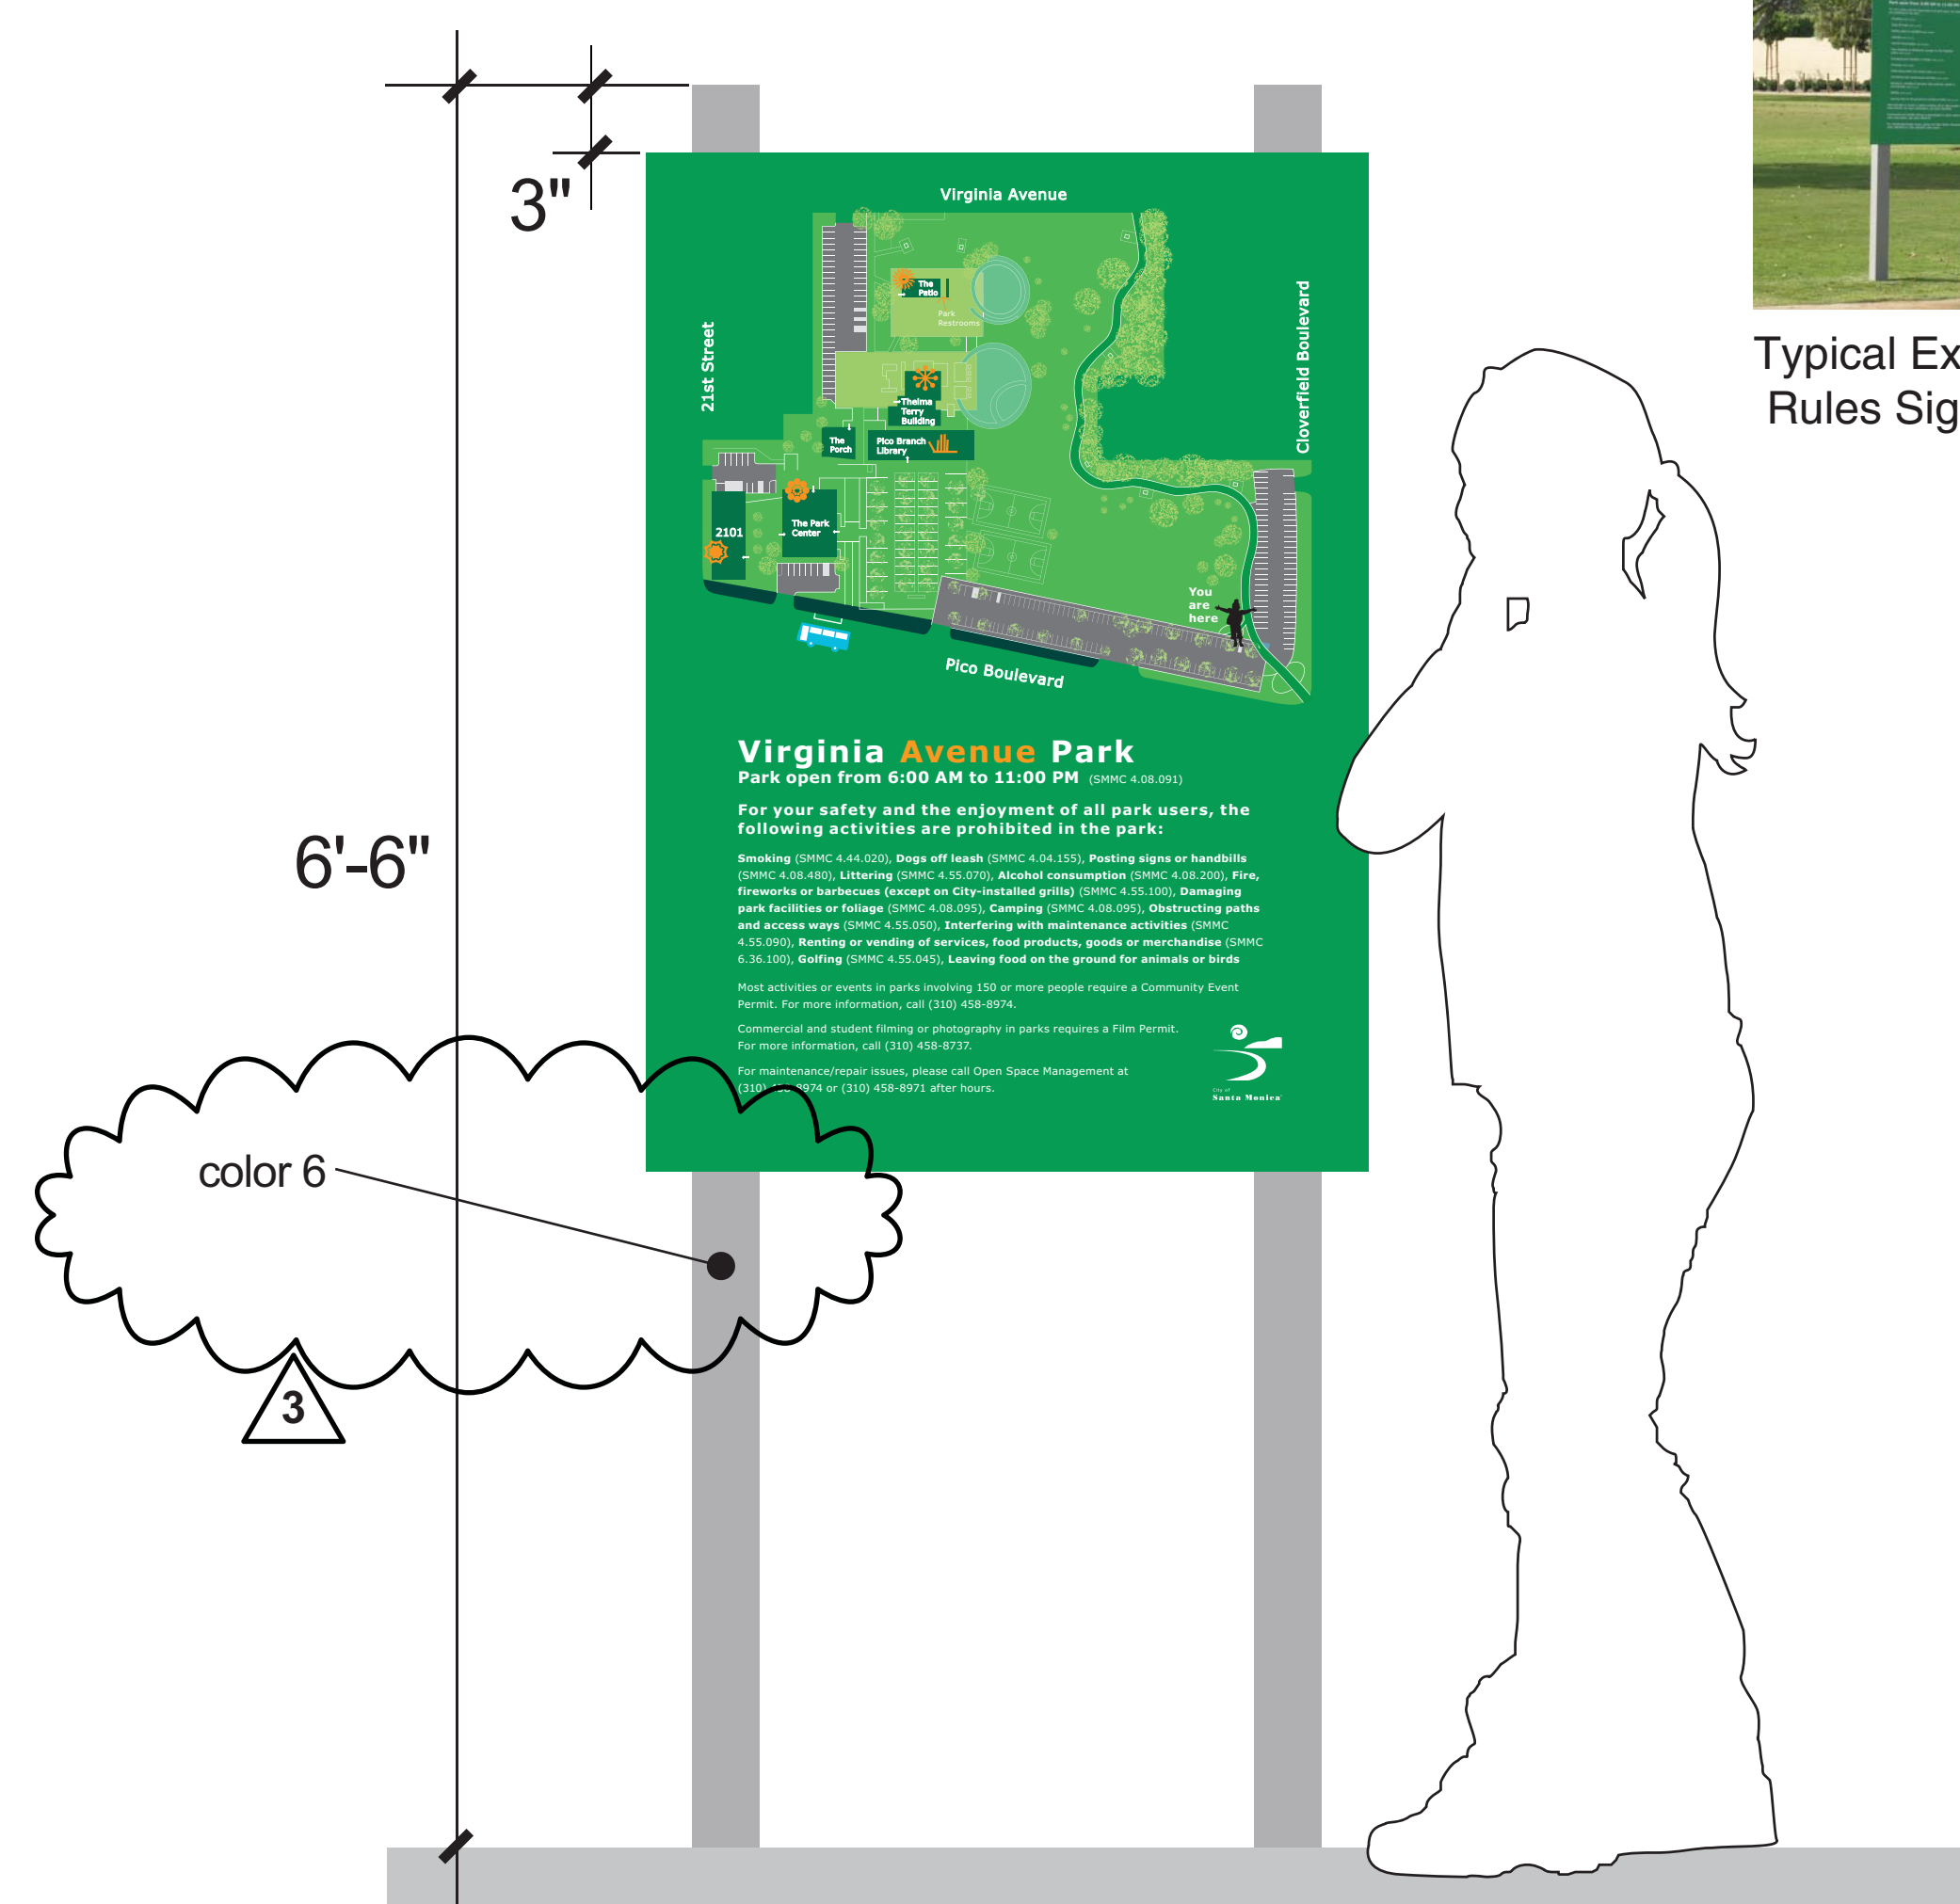

Replace the 4 existing rules panels with new panels incorporating a "you are here" map.

Existing panels are 32 in by 42 in. New panels may increase in height to 45".

Refurbish (clean, sand, patch, paint, replace attachments if needed) existing support posts.



New panels may be:

1. Painted 1/8" aluminum with direct digitally printed graphics. 1 custom color plus full continuous color graphics. Matte UV and graffiti coating.
2. painted 1/8" aluminum with digital vinyl inkjet printout. Exterior grade with Matte UV and graffiti coating. 1 custom color plus full continuous color graphics.
3. Exterior grade high pressure laminate panel (thickness TBD) such as Folia™ or equal. Waterproof, UV, graffiti, burn and corrosion resistant.

Graphics shown are not final.

3 SIGN TYPE 3.00: NEW FACES FOR EXISTING RULES SIGNS

1 1/2"=1'-0"

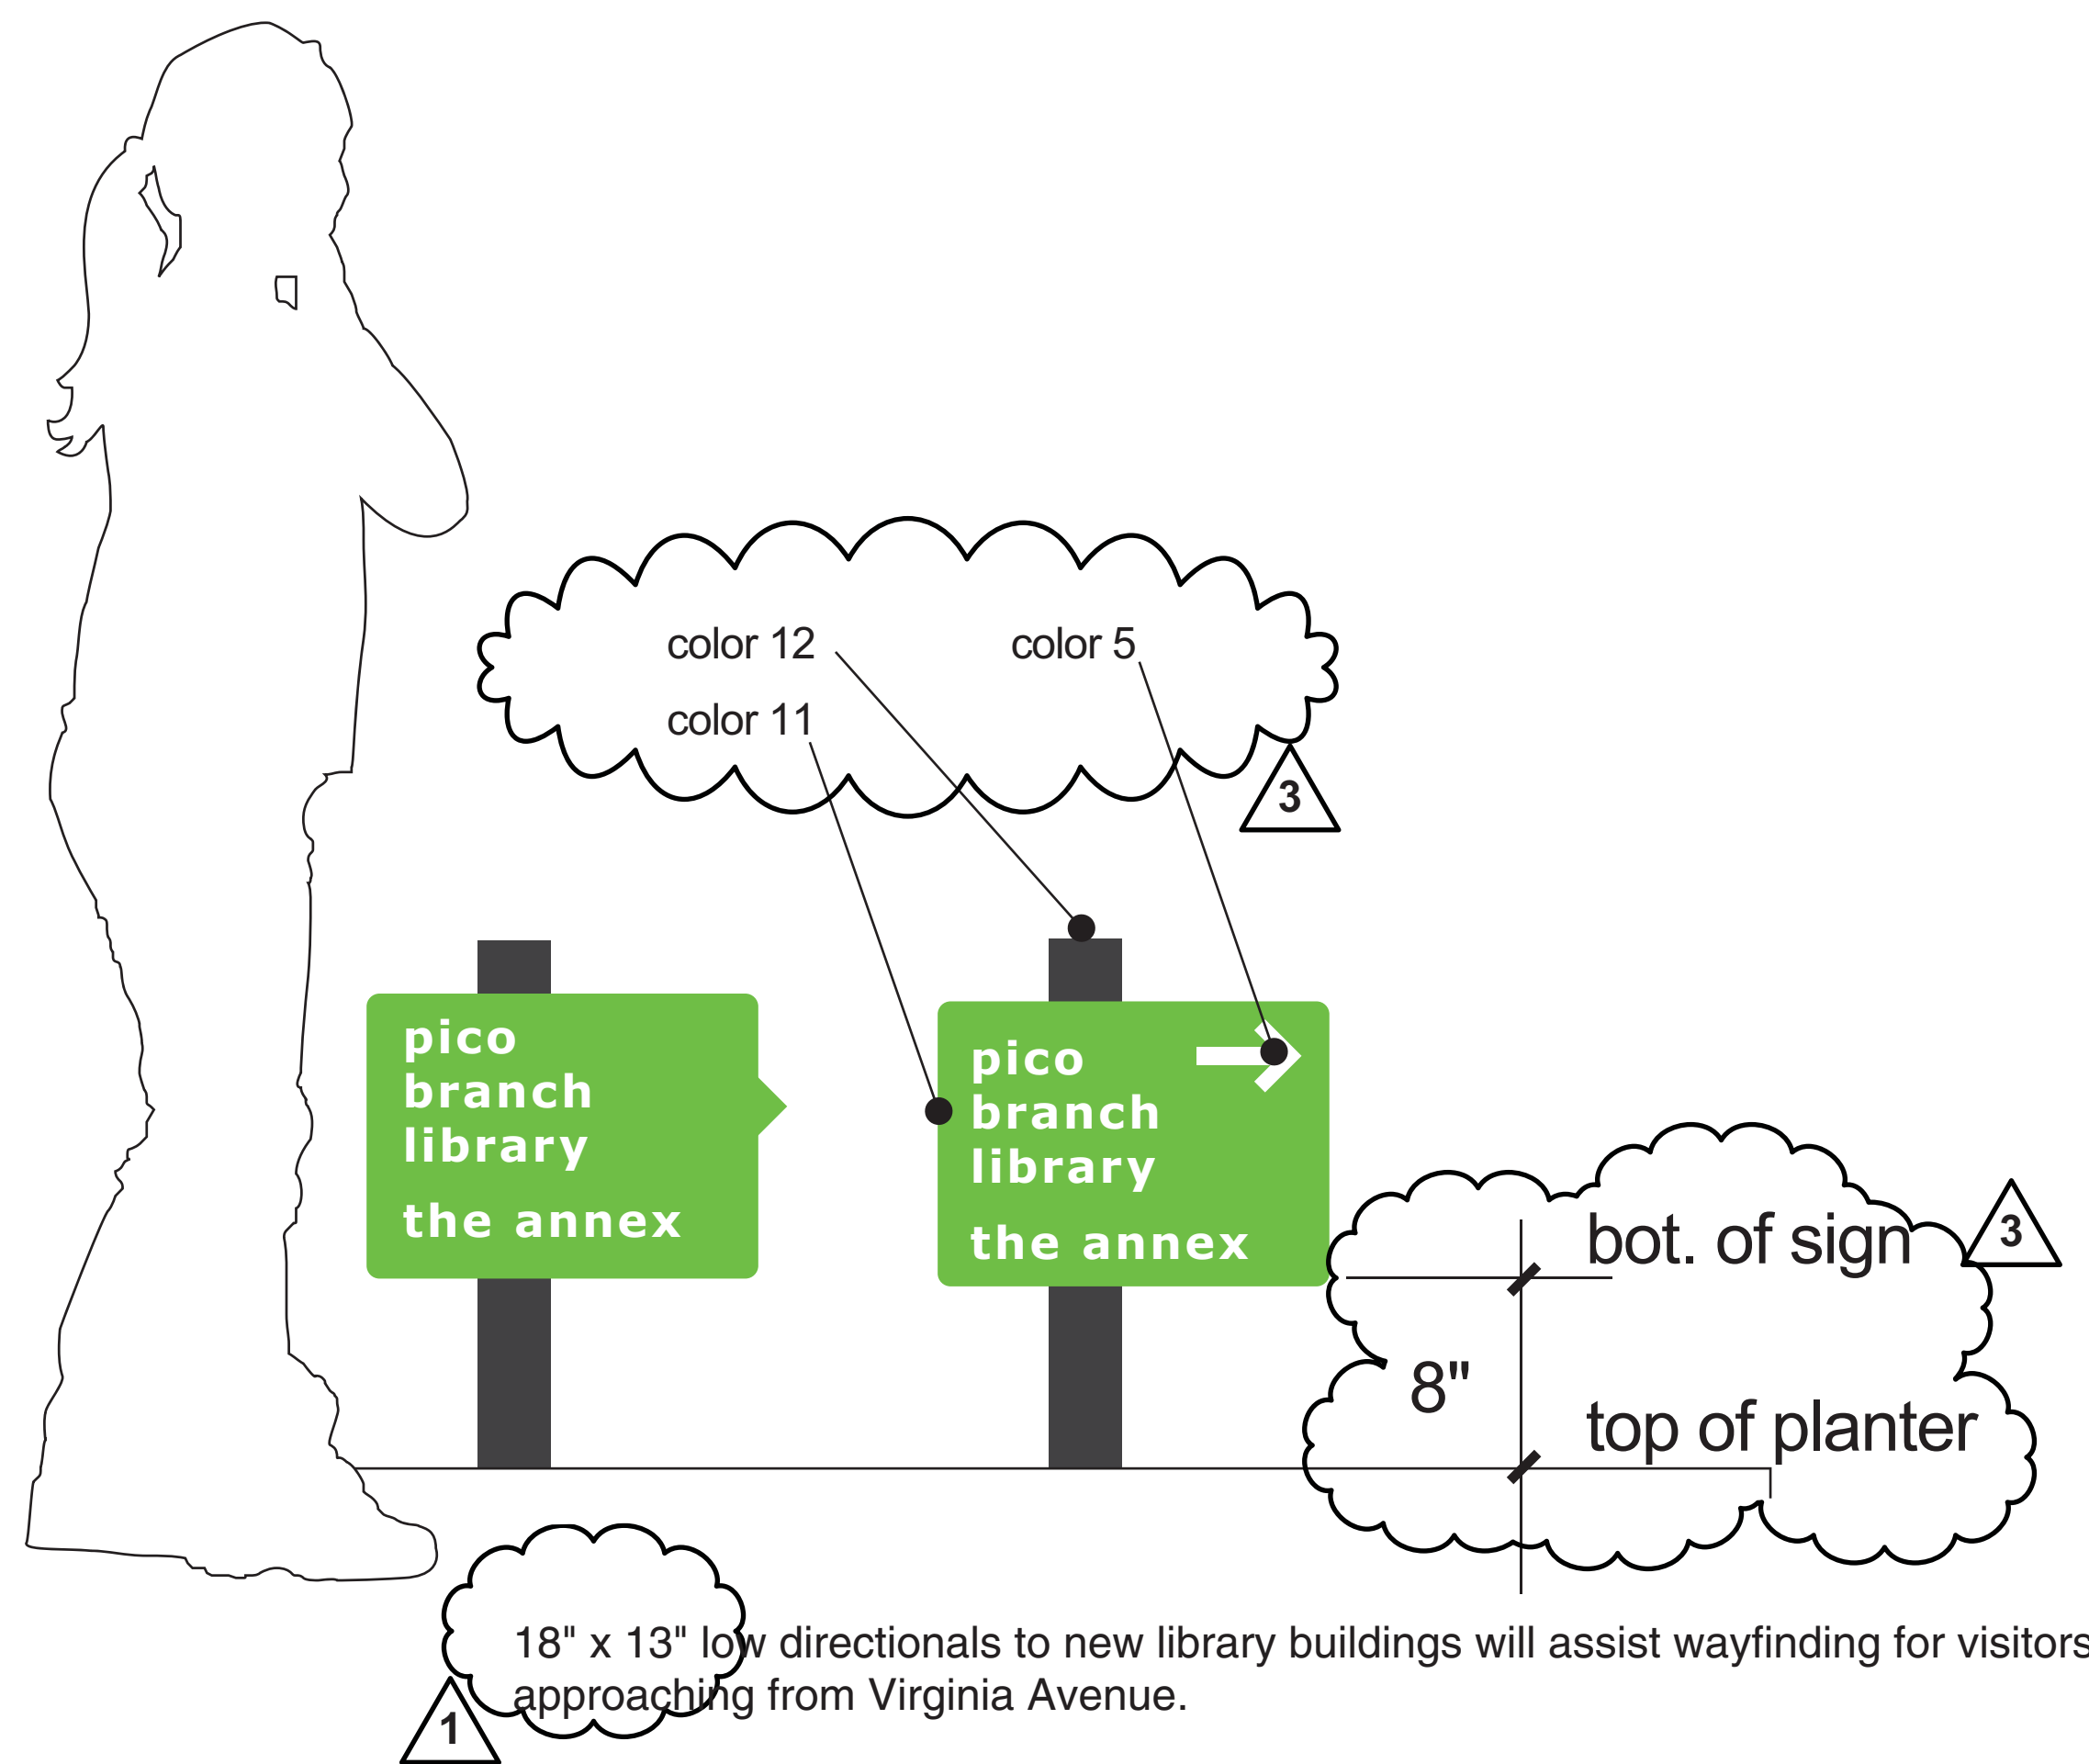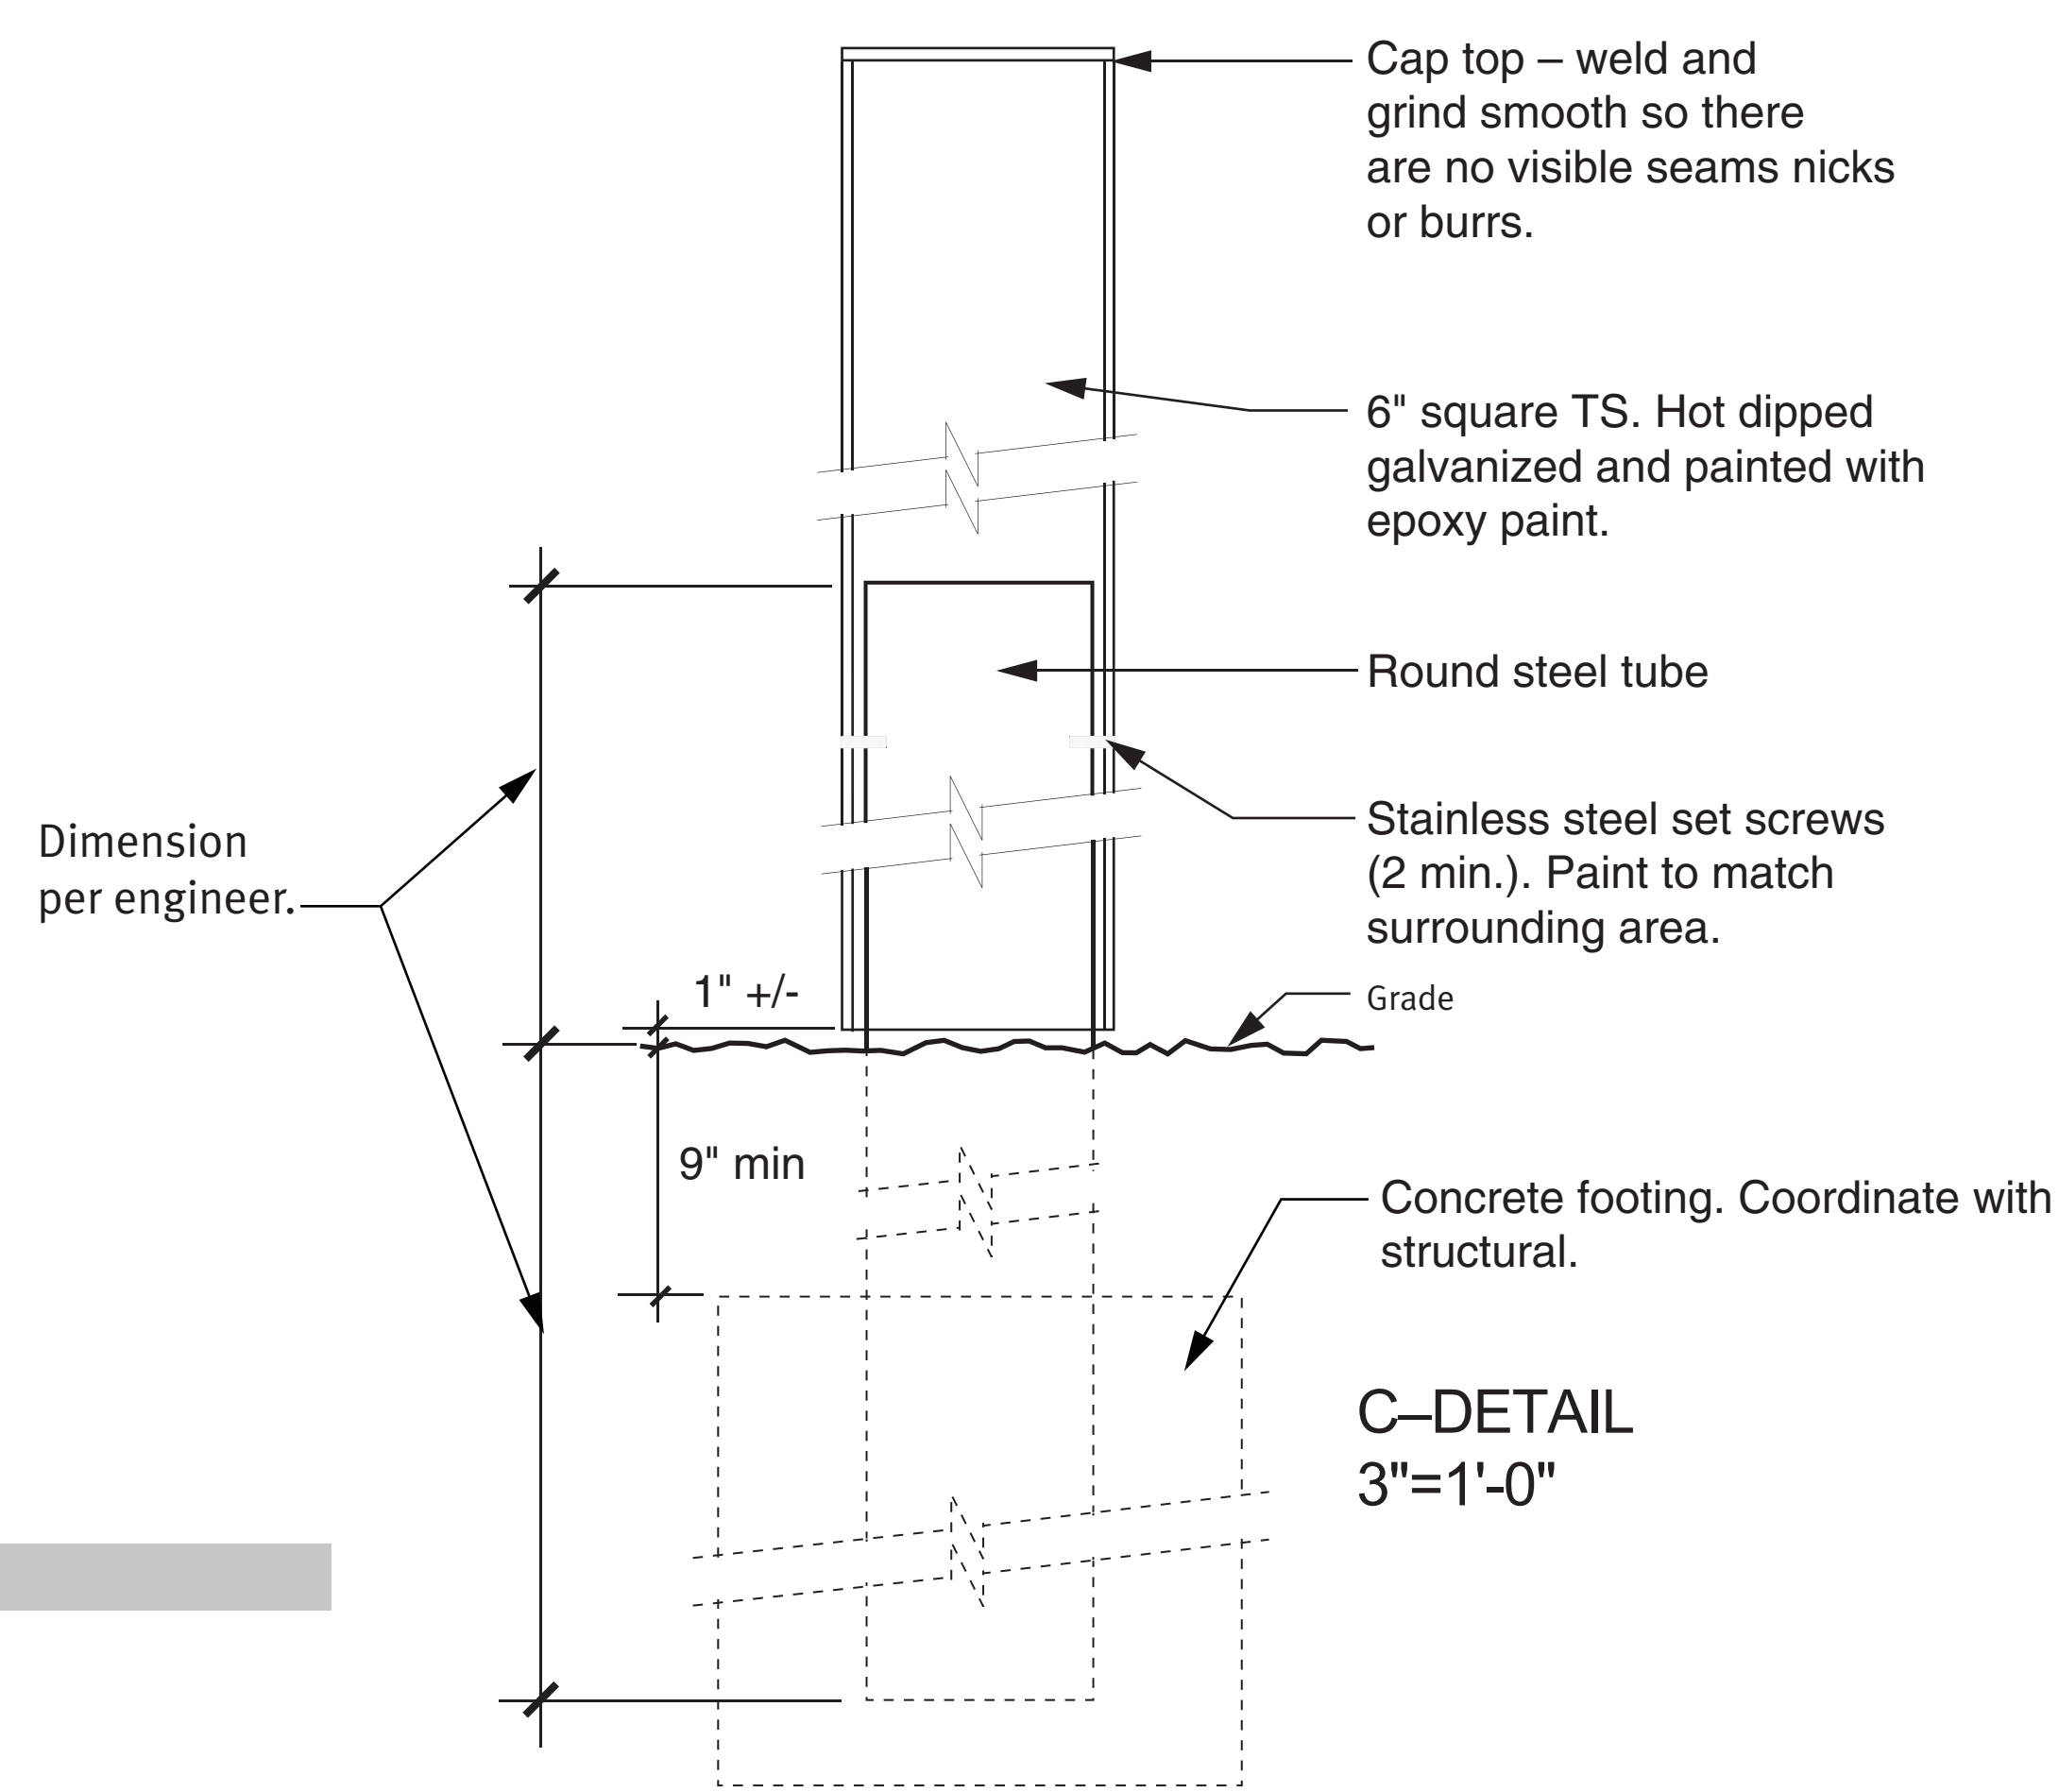

1/8" thick painted aluminum panels. Paint all faces and edges of panels. Silkscreened copy and art. Radiused corners and eased edges all panels. Allow for 3 custom colors TBD. Attach to 3" sq capped painted aluminum tube. See detail 1B - Back view at bolts, for attachment info. Footings required. Coordinate with structural.

Locate in planters. Final locations TBD.


Quantity: 5

2 SIGN TYPE B2: EXTERIOR LIBRARY DIRECTIONAL


1 1/2"=1'-0"



Front and back view of on of the existing directionals. NOTE: Current configuration may hve changed since photograph was taken. Final configuration with additional Library and Annex blades TBD. The final order of the blades TBD.

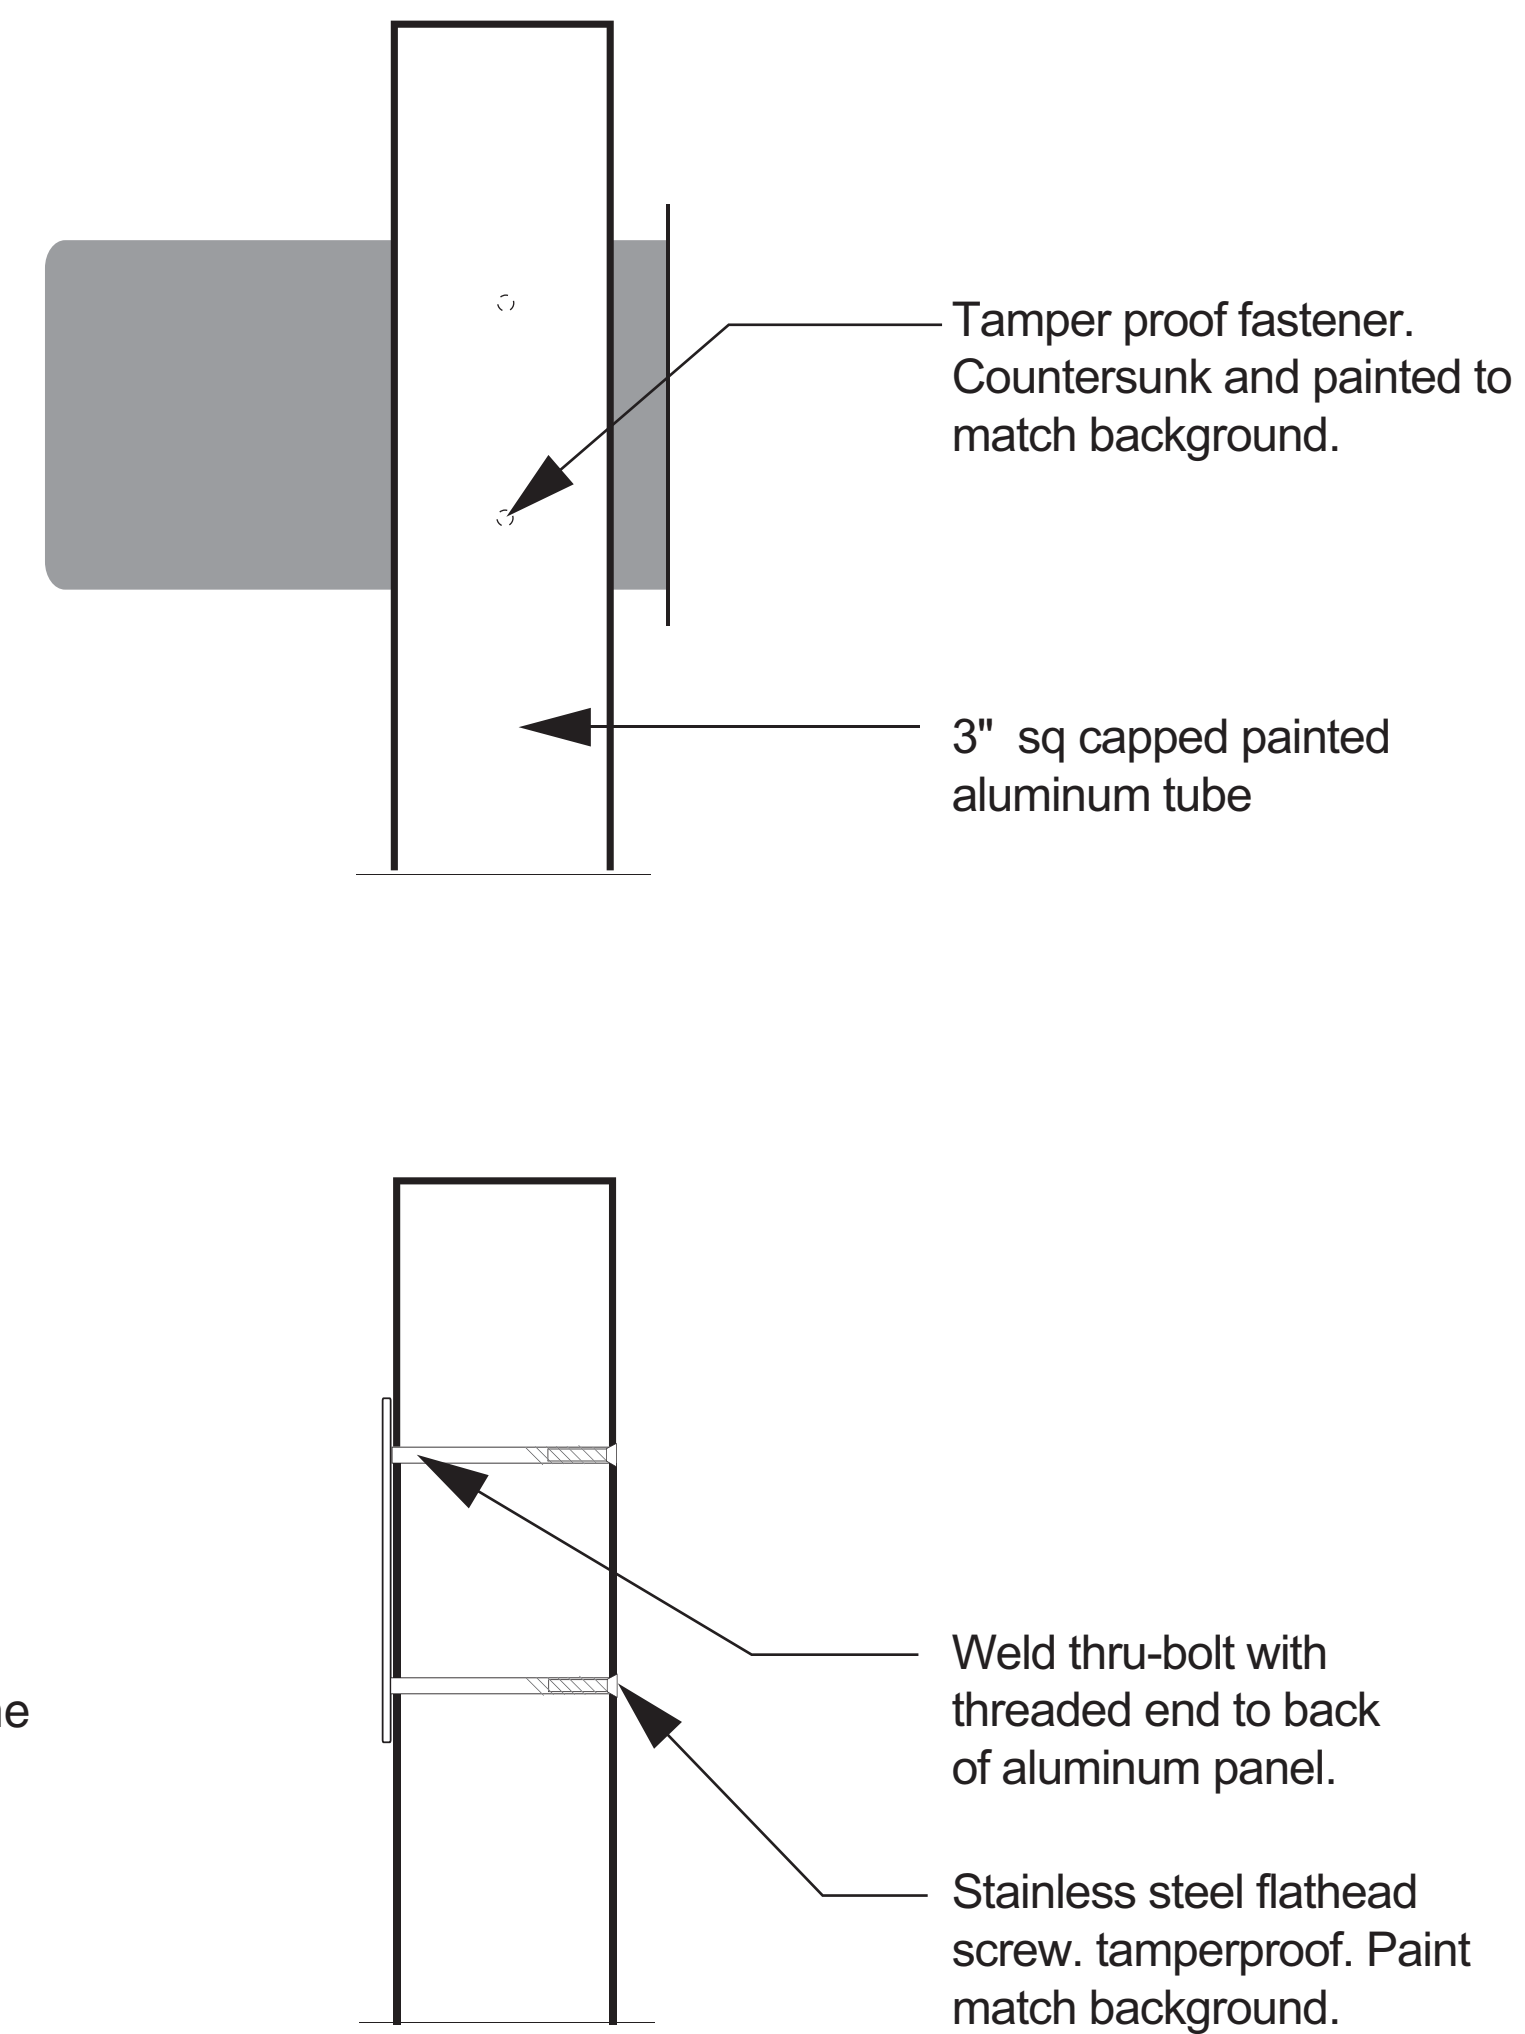

B-BACK VIEW @ BOLTS 3"=1'-0"

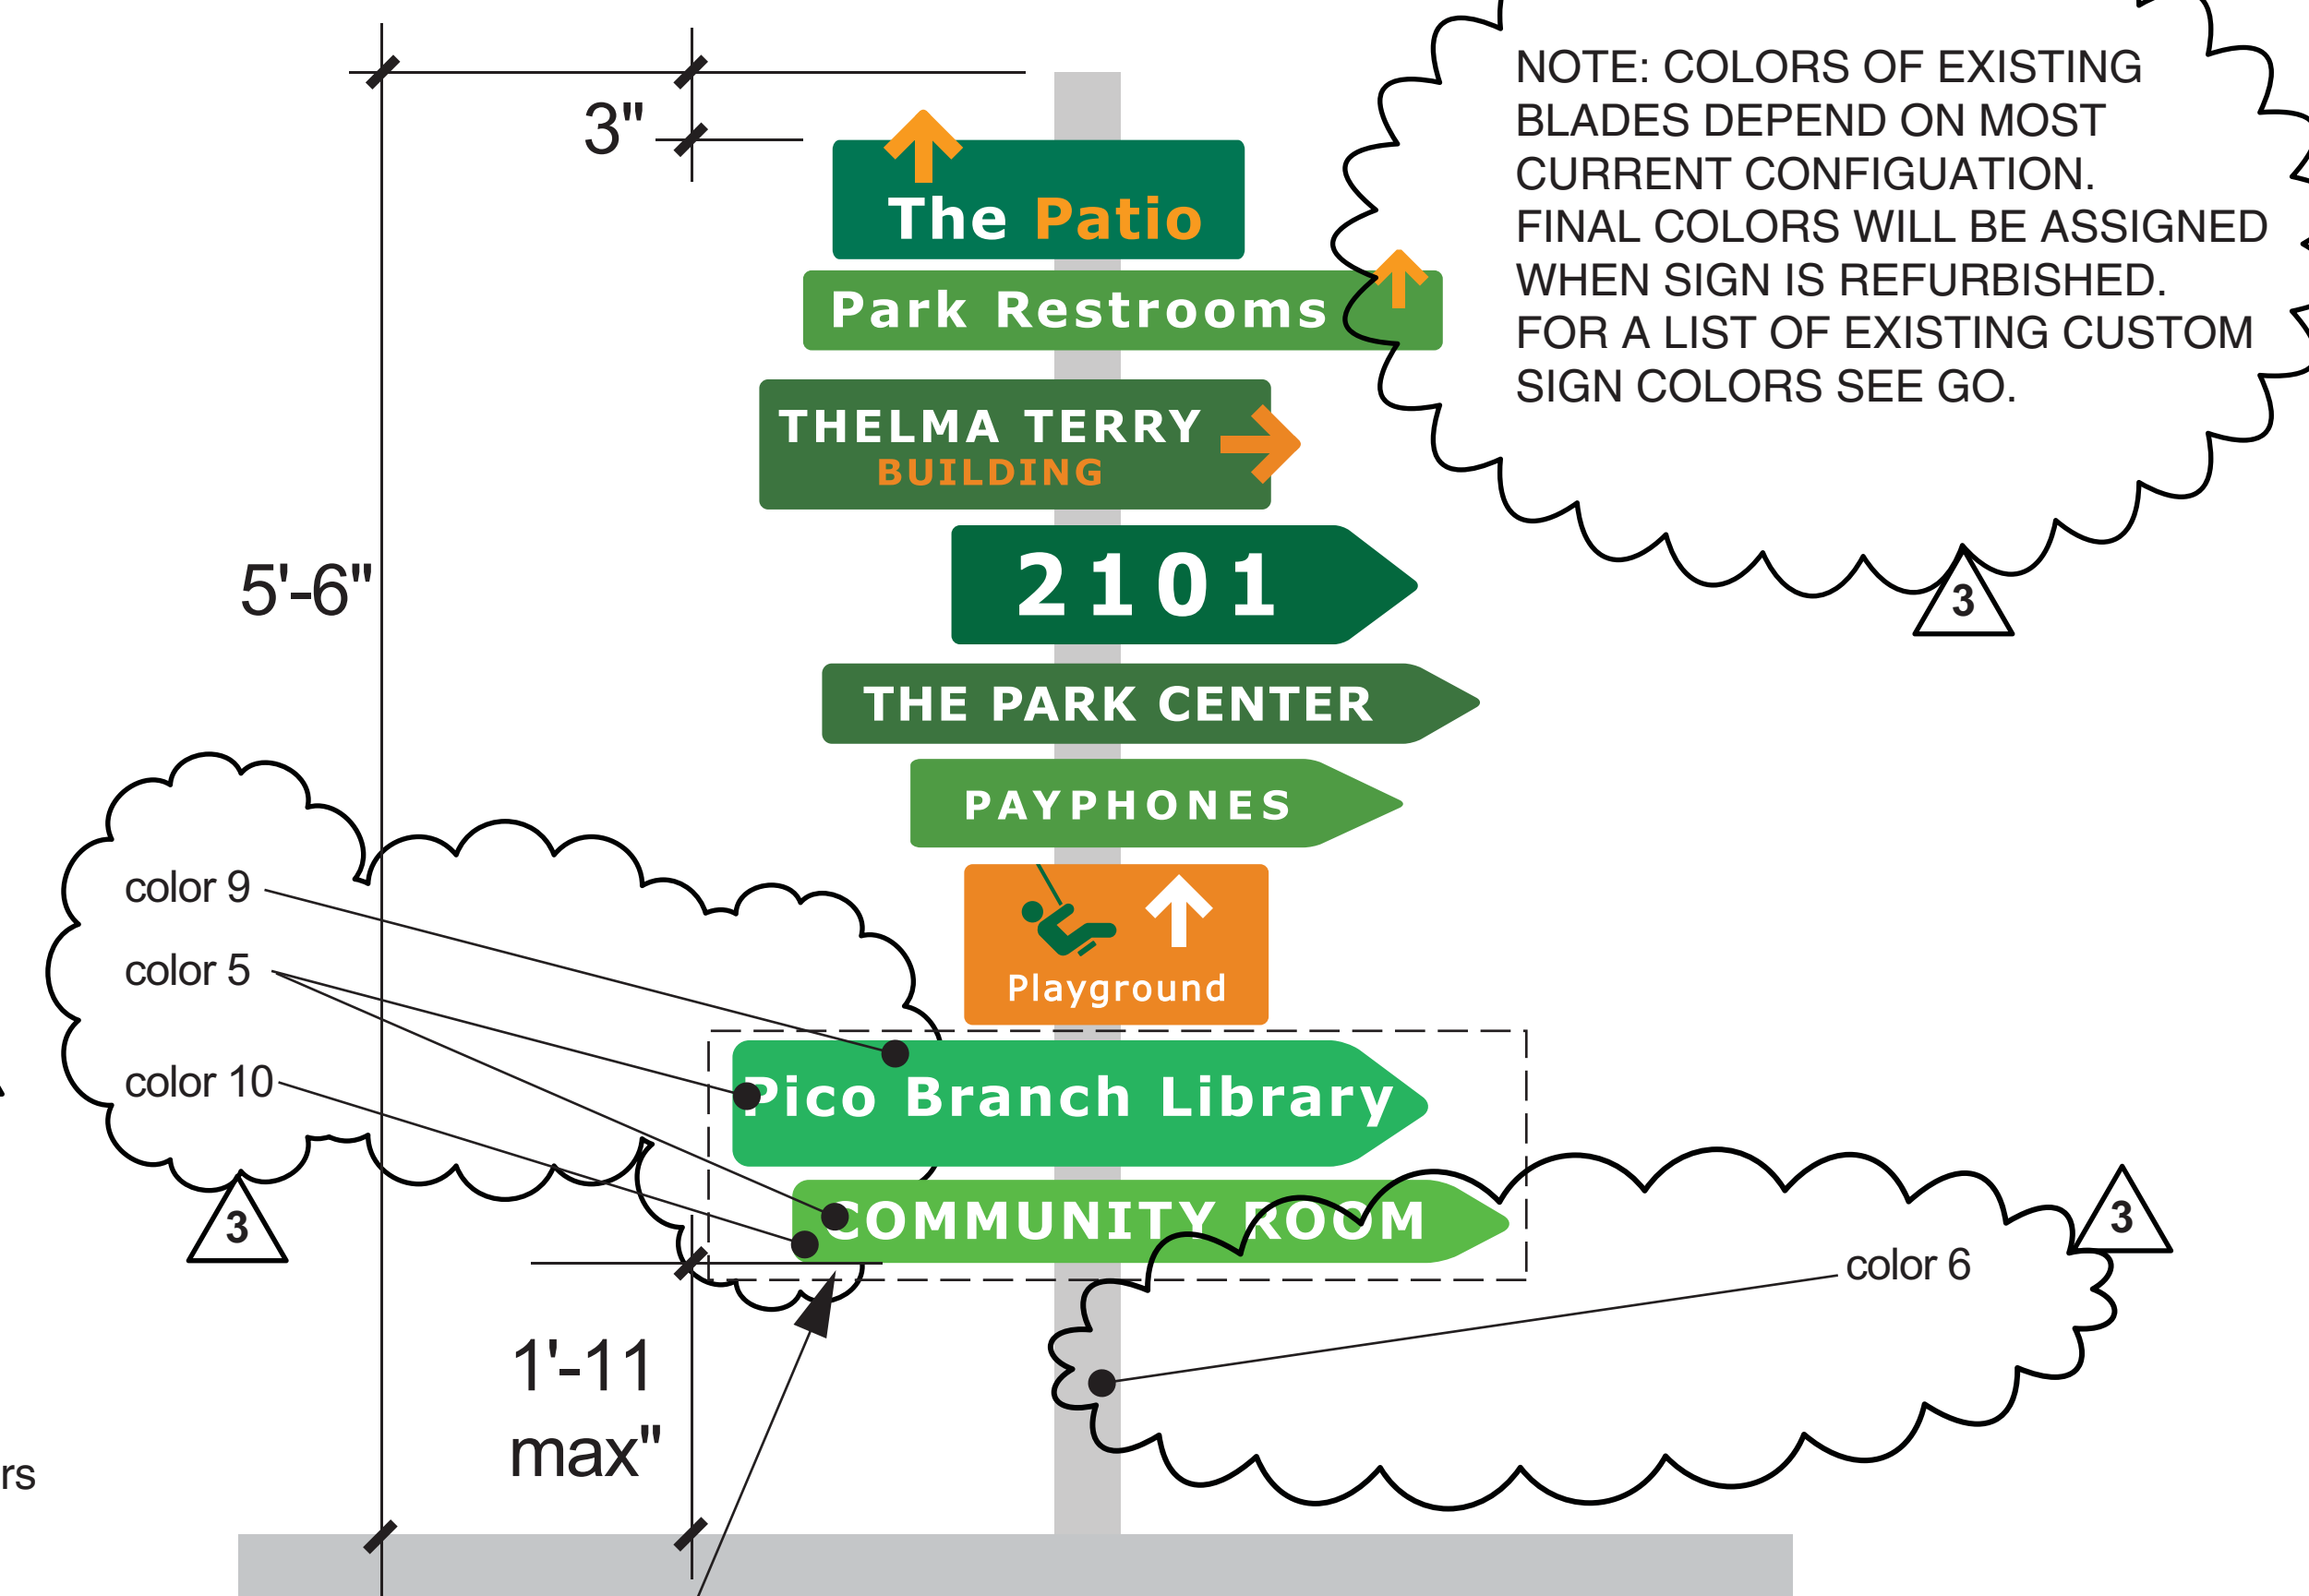

Add 2 new painted aluminum panels, 1/8" thick to the 2 existing directionals. Paint all faces and edges of panels. Silkscreened copy and art. Radiused corners and eased edges all panels. Allow 3 custom colors.

NOTE:

1. Scope of work includes refurbishing (cleaning, sanding, patching, painting, replacing attachments, changing order of blades) existing plaques.
2. The 2 existing directionals have different configurations. New blades will be different at each location.

1 SIGN TYPE 2.00: ADD BLADES TO EXISTING DIRECTIONALS

NTS

KoningEisenbergArchitecture
1454 25th St, Santa Monica, CA 90404
310.828.6131 info@kearch.com
310.828.0719 fax www.kearch.com

All designs, ideas, arrangements and plans indicated by these drawings are the property and copyright of the Architect and shall neither be used on any other work nor be disclosed to any other person for any use whatsoever without written permission.

Koning Eisenberg Architecture and/or its principals and employees waives any and all liability or responsibility for problems that may occur when these plans, drawings, specifications, and/or designs are followed without the professional's guidance with ambiguities, or conflicts which are alleged.



7906 W. 4th St. Los Angeles, Ca 90048
323 658-7955 Fax 323 658-7961

City of
Santa Monica
Architecture Services

1437 4TH STREET, SUITE 300
SANTA MONICA, CA 90401
TEL: (310) 456-2205
FAX: (310) 399-1541
architecture@smgov.net

DATE: 20

SUBMITTED BY:

DATE: 20

APPROVED BY:

Miriam Mulder
Architecture Services Manager
CITY OF SANTA MONICA
DEPARTMENT OF PUBLIC WORKS

REVIEWED BY: DATE: 20


REVIEWED BY: DATE: 20

REVIEWED BY: DATE: 20

| NO. | DATE | BY | DESCRIPTION |
|-----|----------|----|--------------|
| 1 | 07/16/12 | | BULLETIN 1 |
| 2 | 06/21/12 | | PLAN CHECK 2 |
| 3 | 05/07/12 | | PLAN CHECK 1 |
| 4 | 03/06/12 | | ADDENDUM 3 |
| 5 | 02/21/12 | | ADDENDUM 2 |


DATE: 06/21/2012

DRAWING NO. 6693


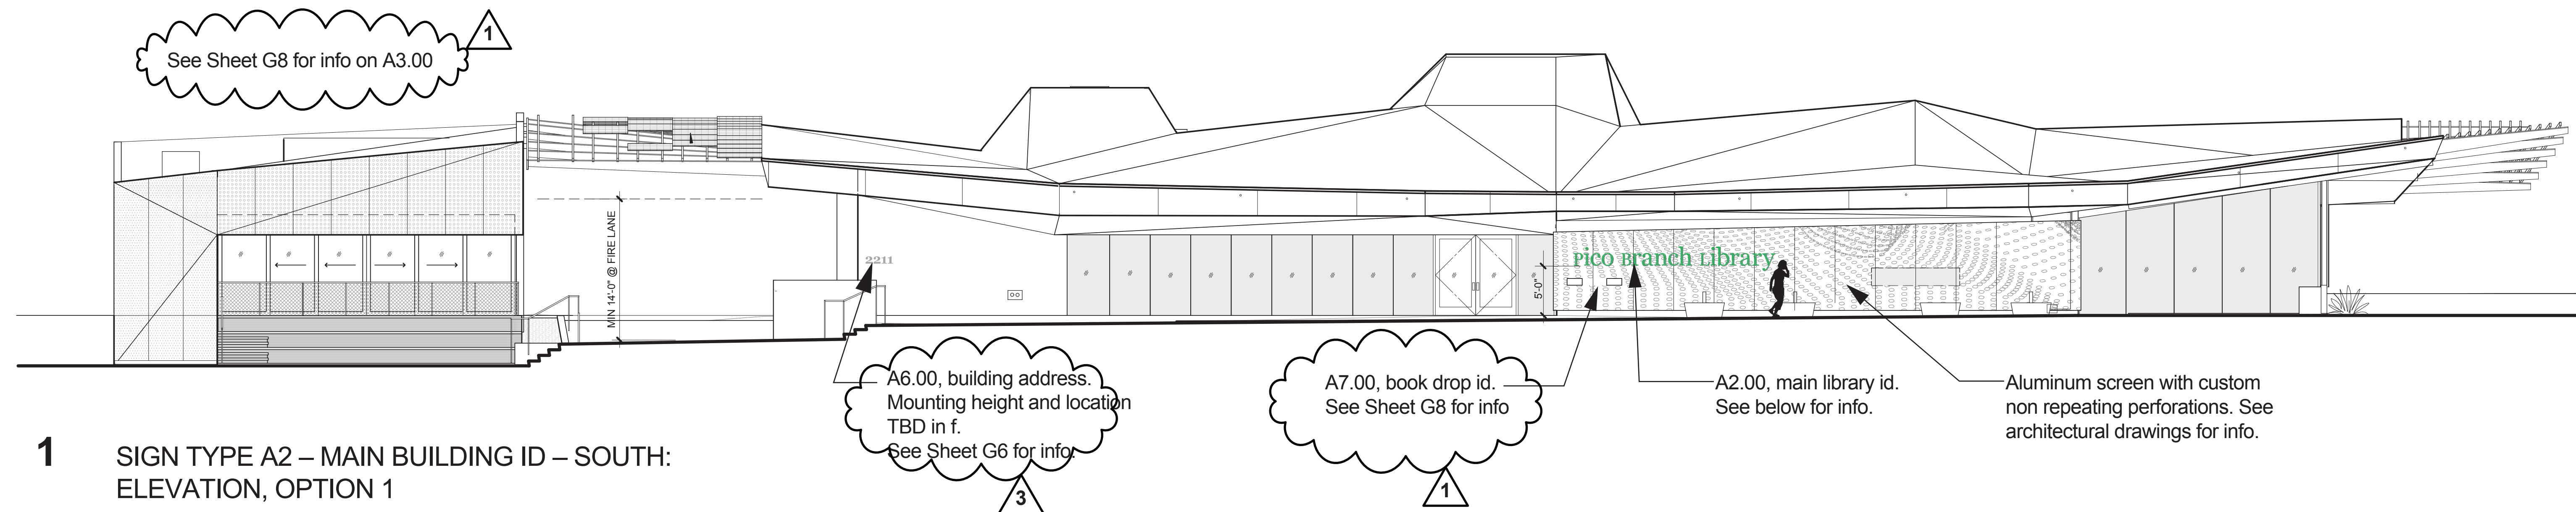


1 SIGN TYPE A2 – MAIN BUILDING ID – SOUTH:
ELEVATION, OPTION 1
1/8"=1'-0"


Pico Branch Library

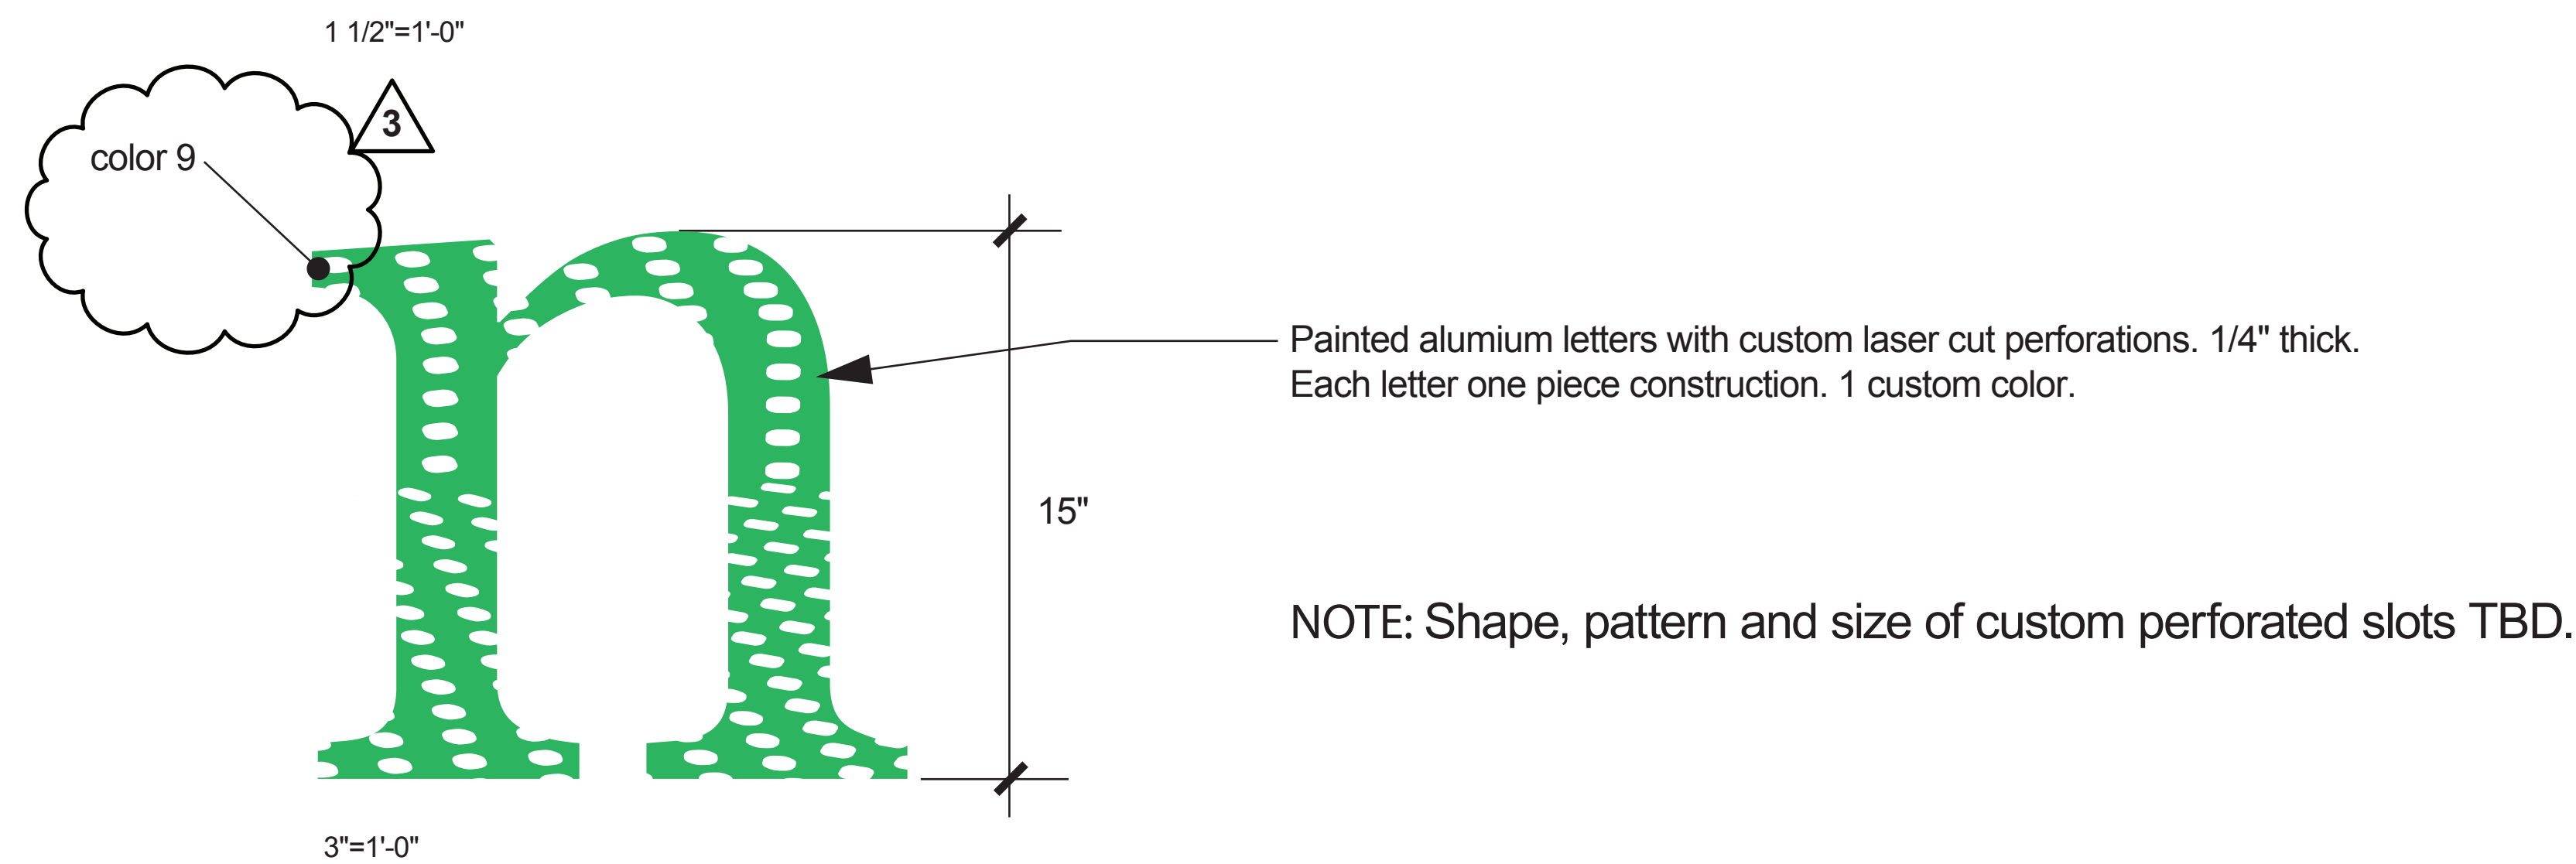

2 SIGN TYPE A2 – MAIN BUILDING ID – SOUTH:
OPTION 1 DETAIL
Scale as shown

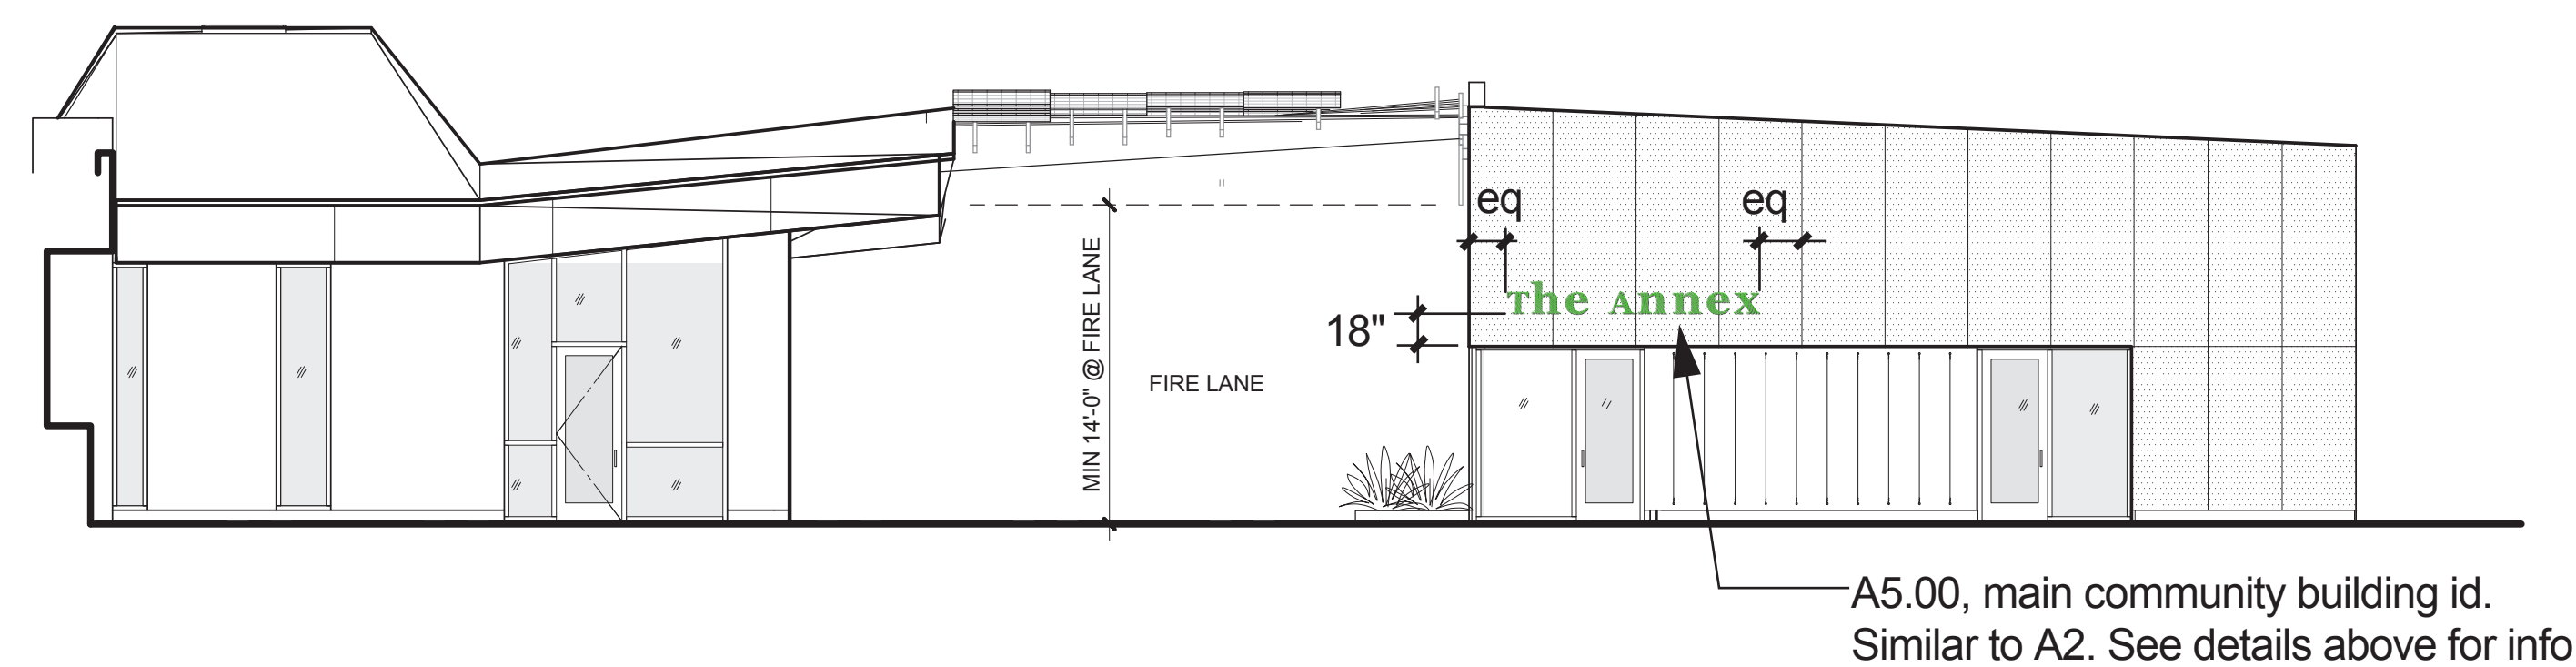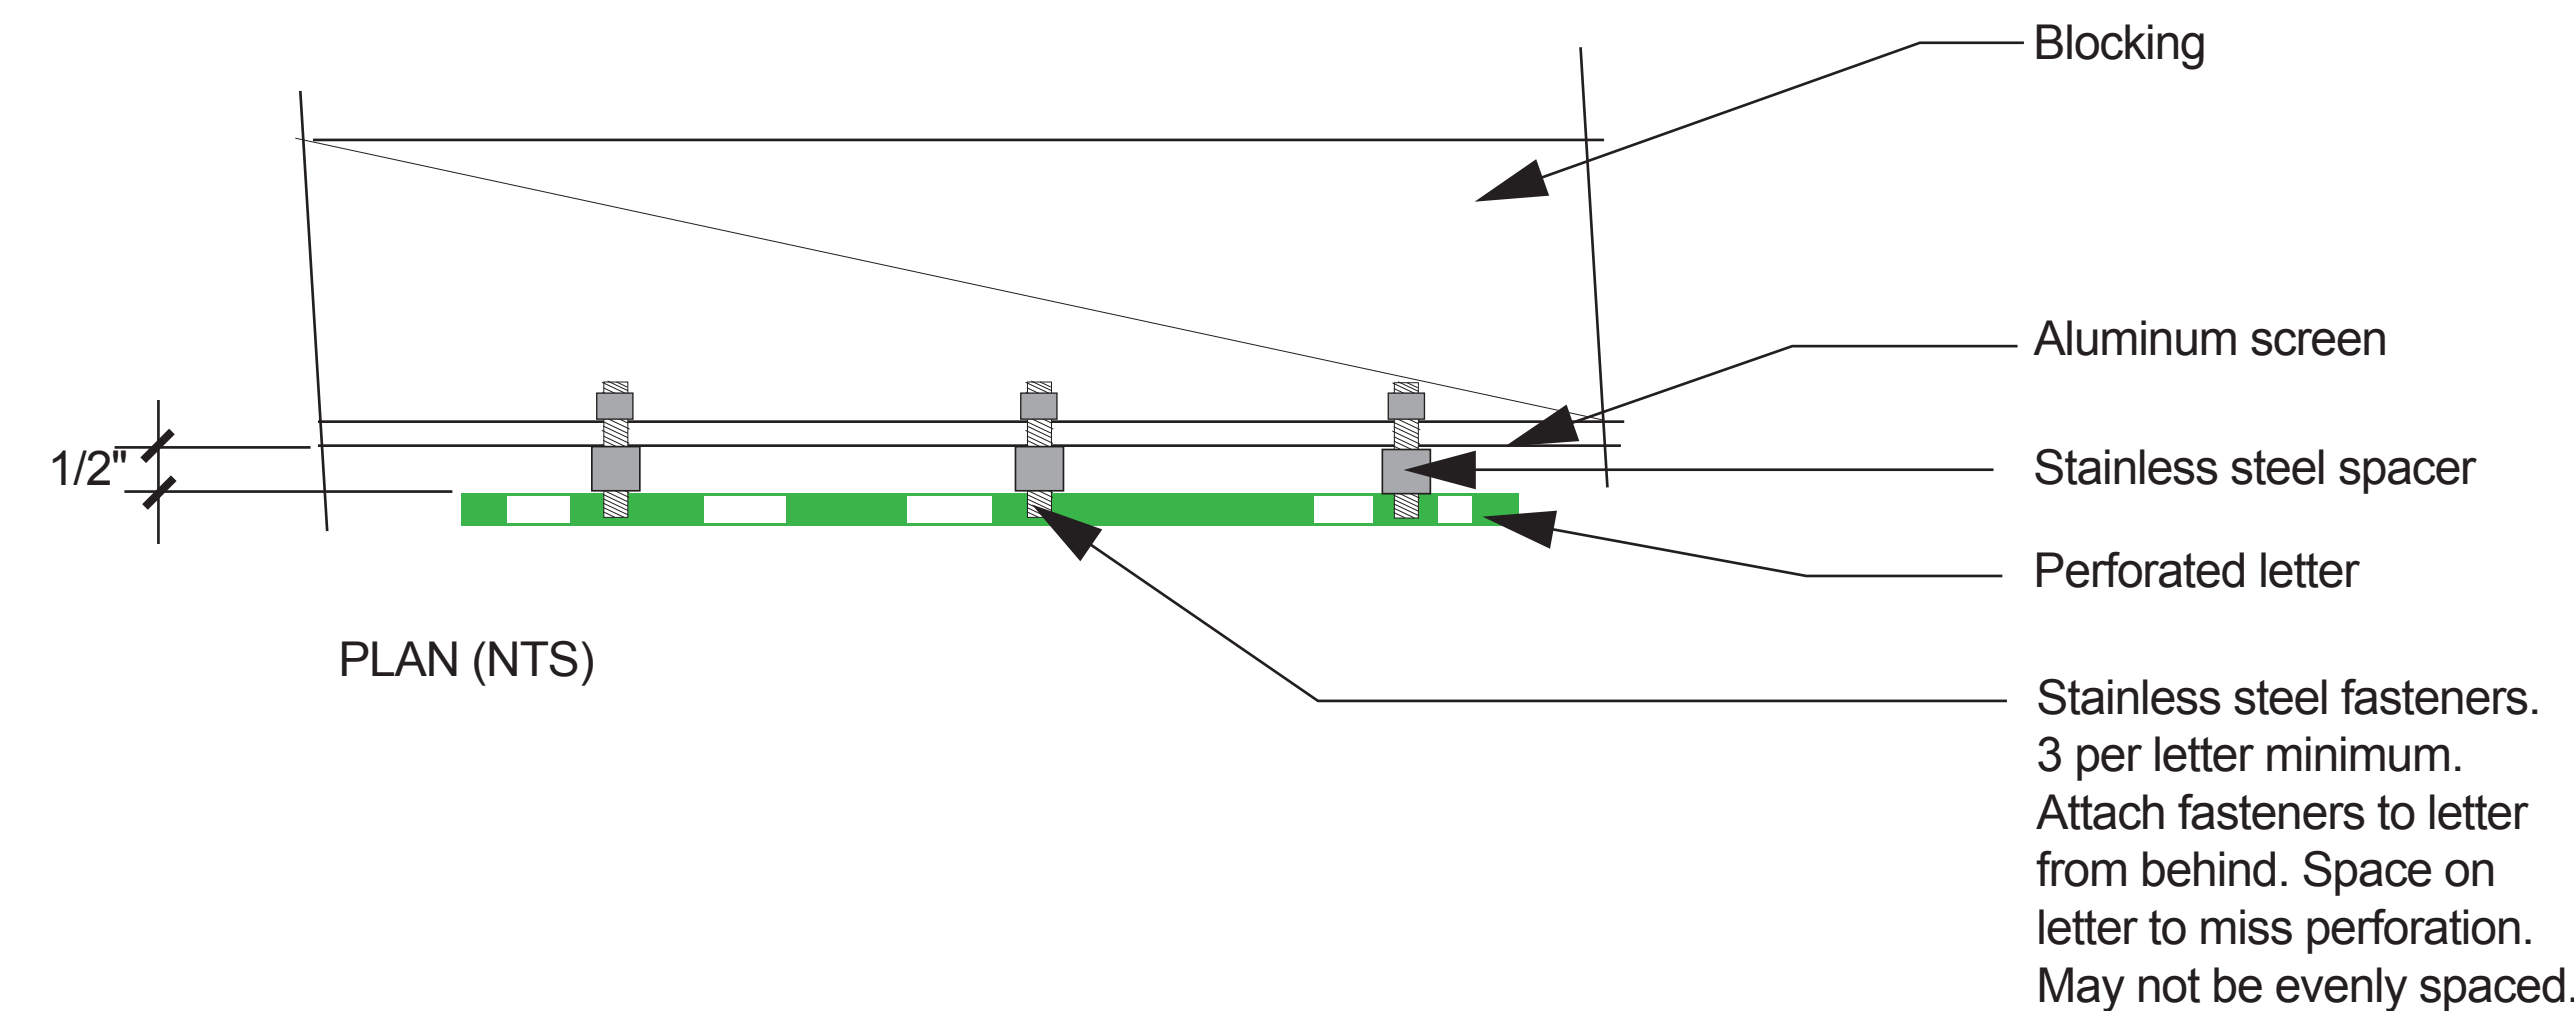

3 SIGN TYPE A5 – COMMUNITY BUILDING ID – NORTH:
ELEVATION, OPTION 1
1/8"=1'-0"

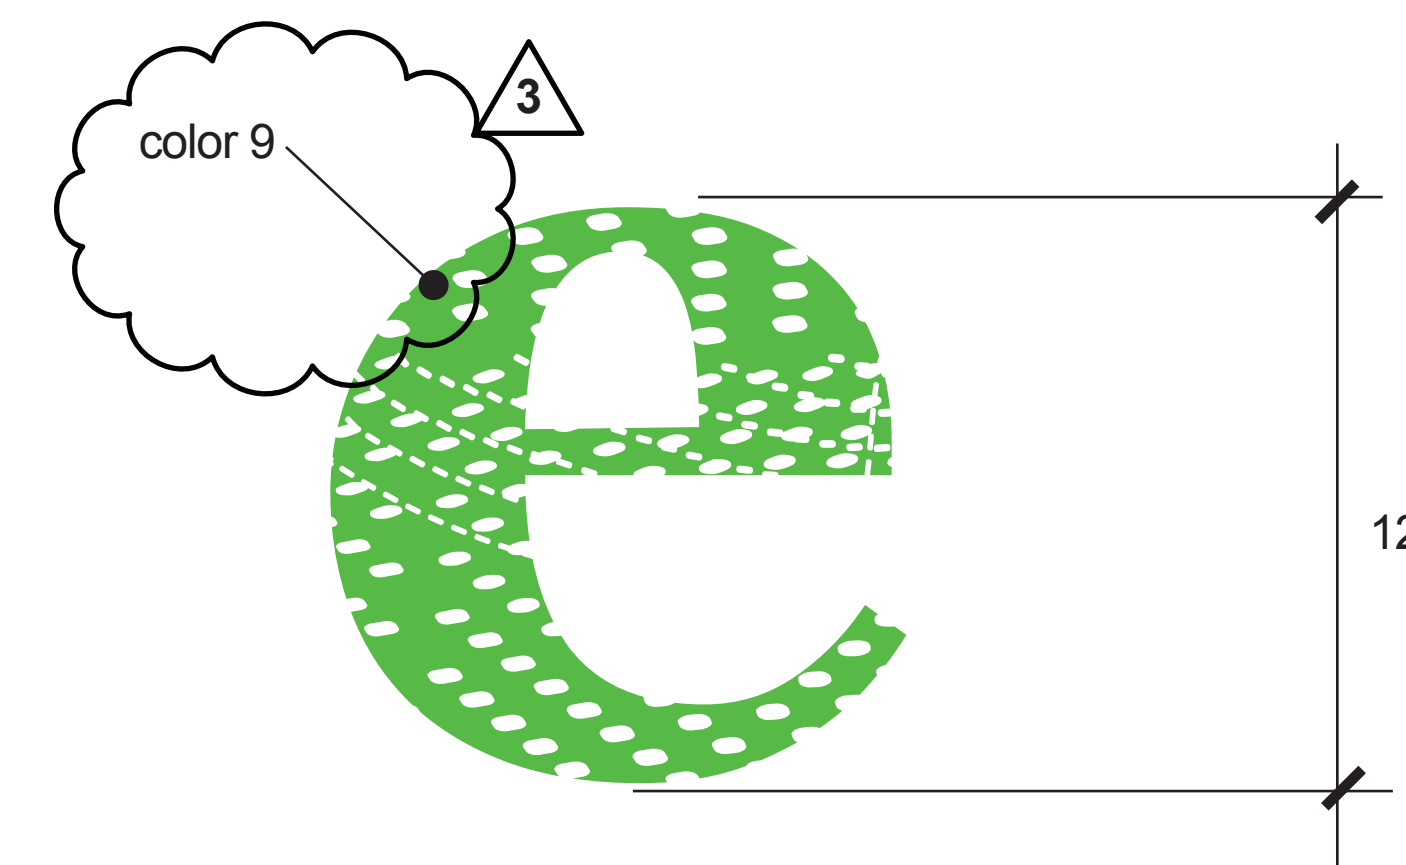

NOTE: Shape, pattern and size of custom perforated slots TBD.
Perforation varies per layer.



| NO. | DATE | BY | DESCRIPTION |
|-----------|----------|----|--------------|
| 1 | 07/16/12 | | BULLETIN 1 |
| 2 | 06/21/12 | | PLAN CHECK 2 |
| 3 | 05/07/12 | | PLAN CHECK 1 |
| 4 | 03/06/12 | | ADDENDUM 3 |
| 5 | 02/21/12 | | ADDENDUM 2 |
| REVISIONS | | | |

1 SIGN TYPES E1 & E6 – WALL TEXTURE GRAPHIC: ELEVATION

1/2"=1'-0"

A9.0 – Dimensional letters.
See sheet A8 for more info.
Center on checkout desk

E6 graphics here
(500 sf +/-)

bottom
of letters
5'-0"

check out

5'-0"

No graphics below 5'-0"
at corner

3

3




3

3
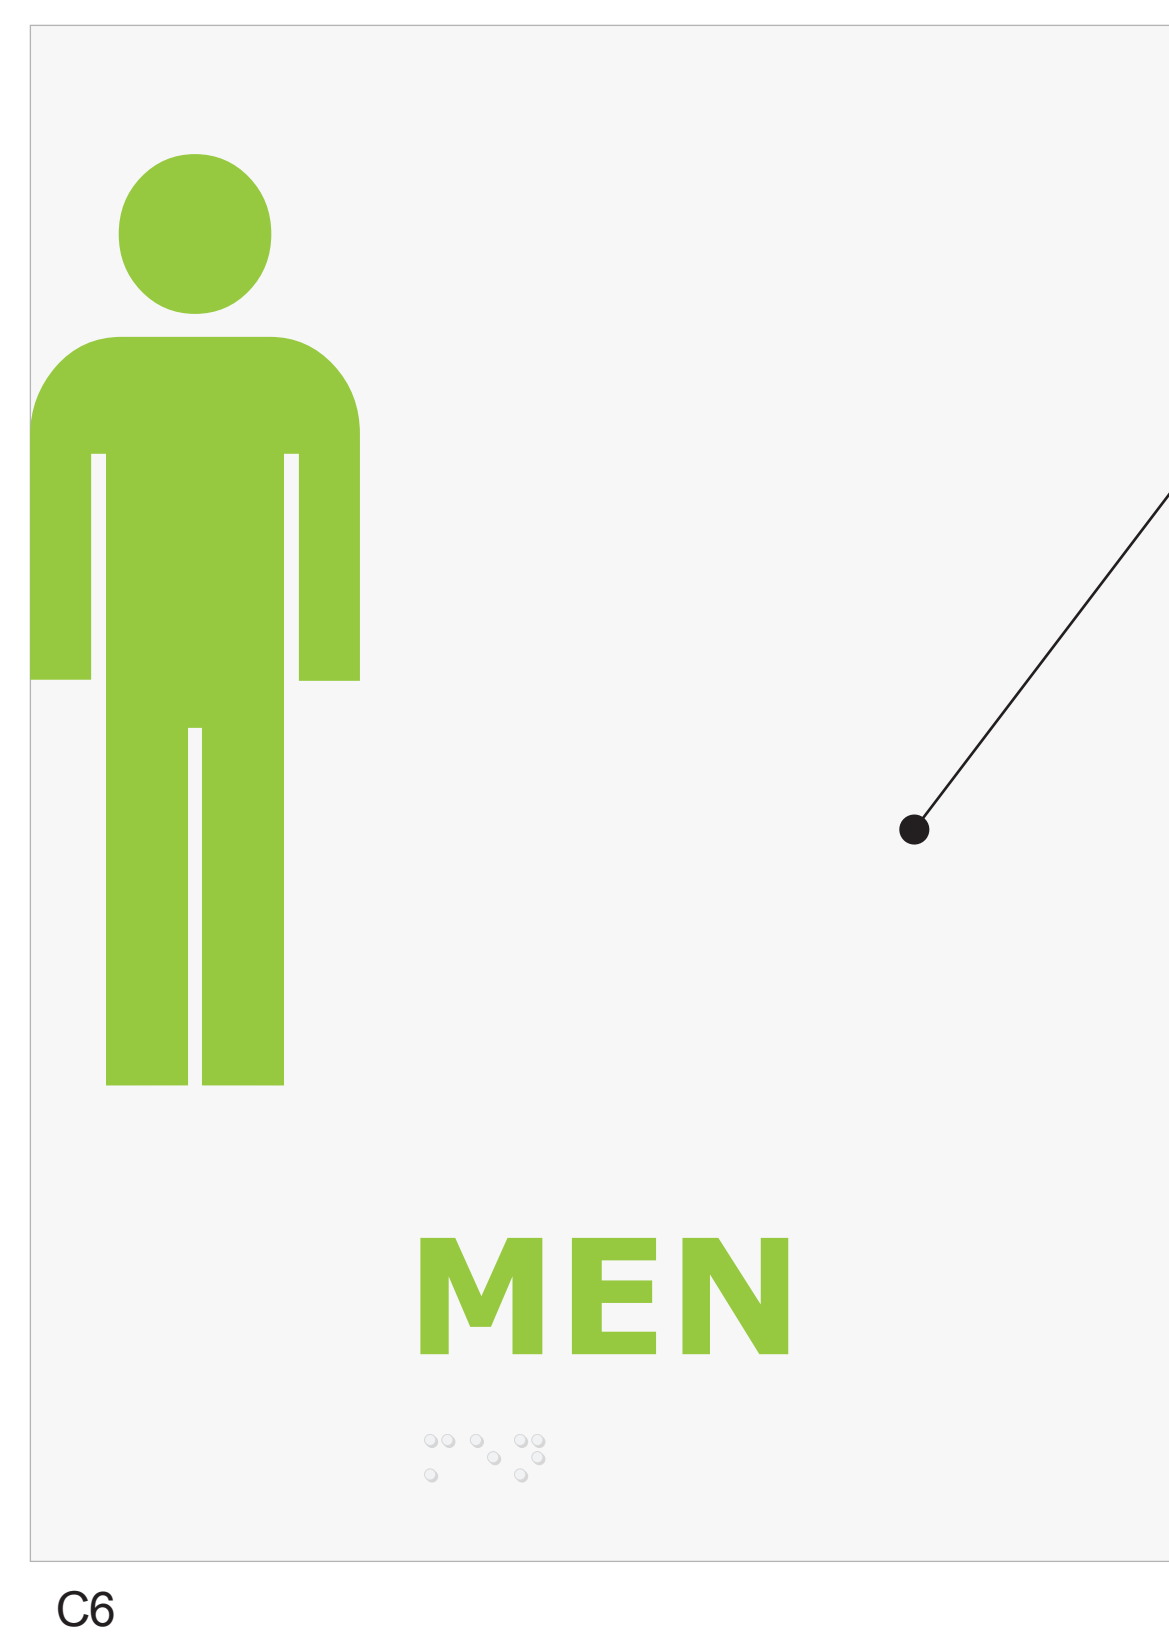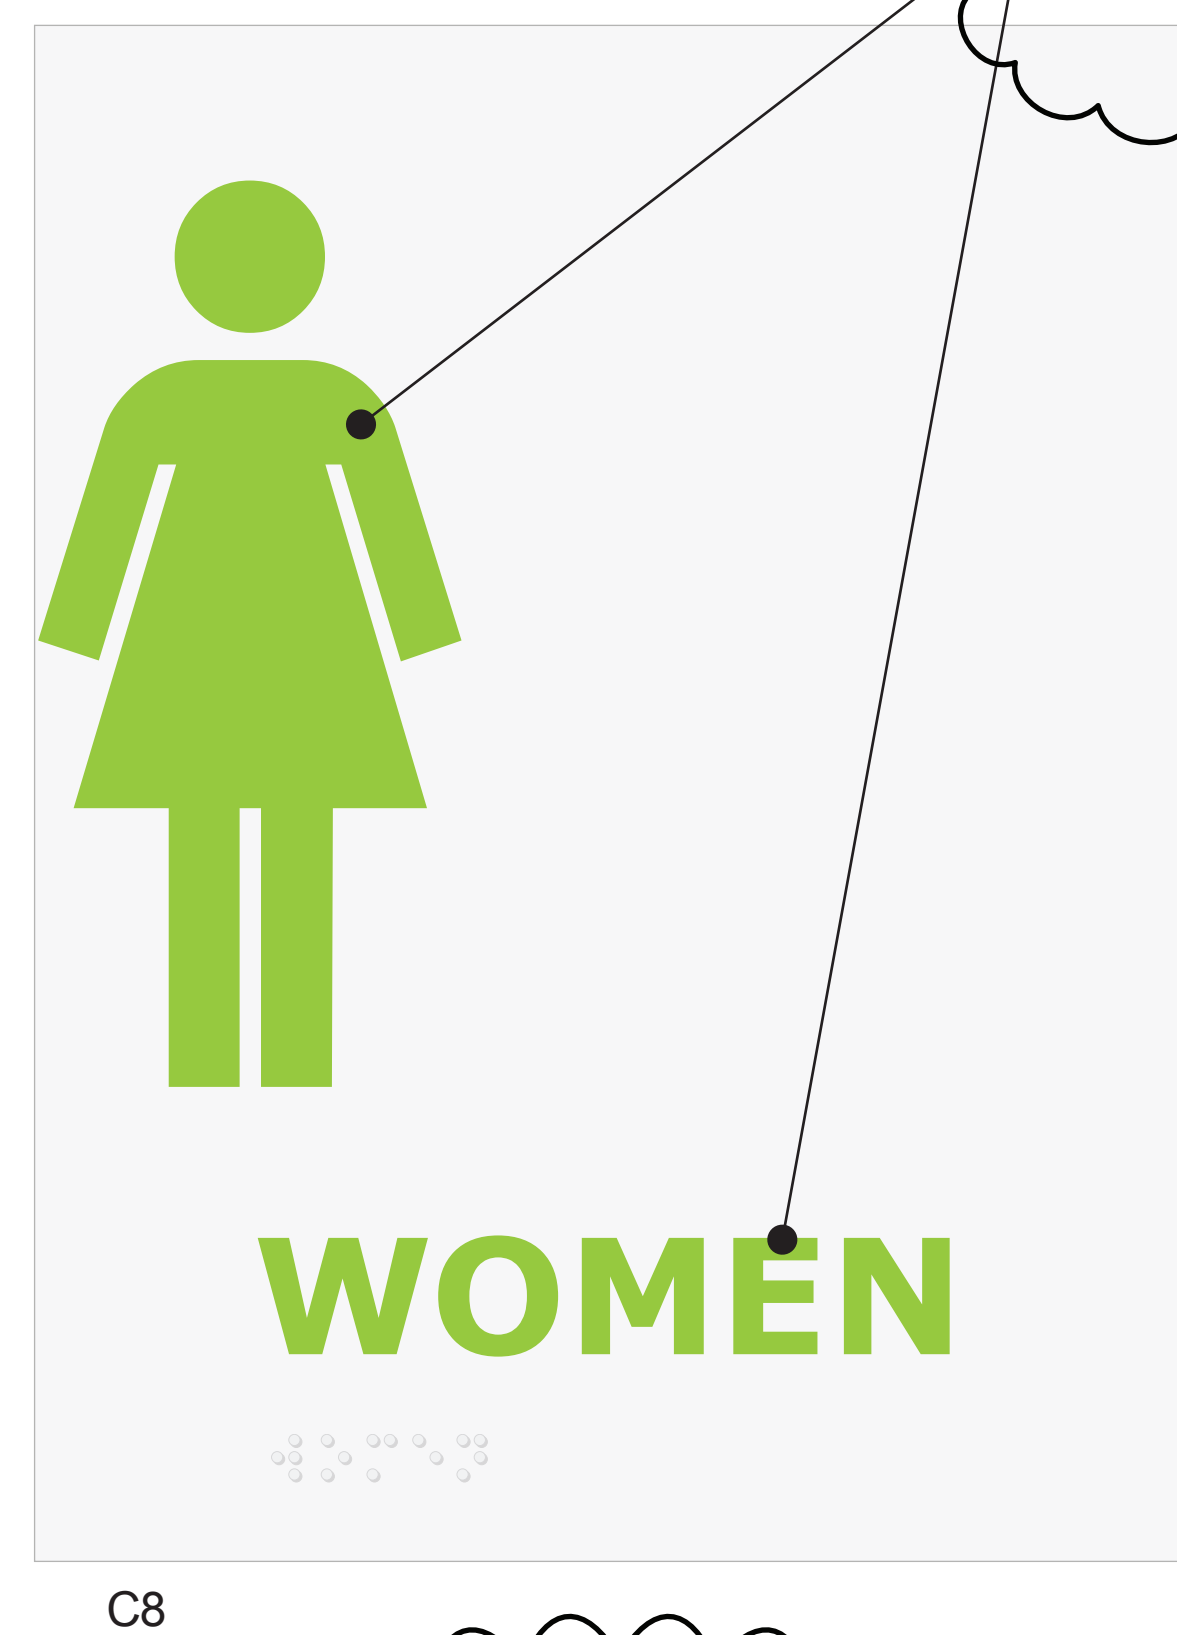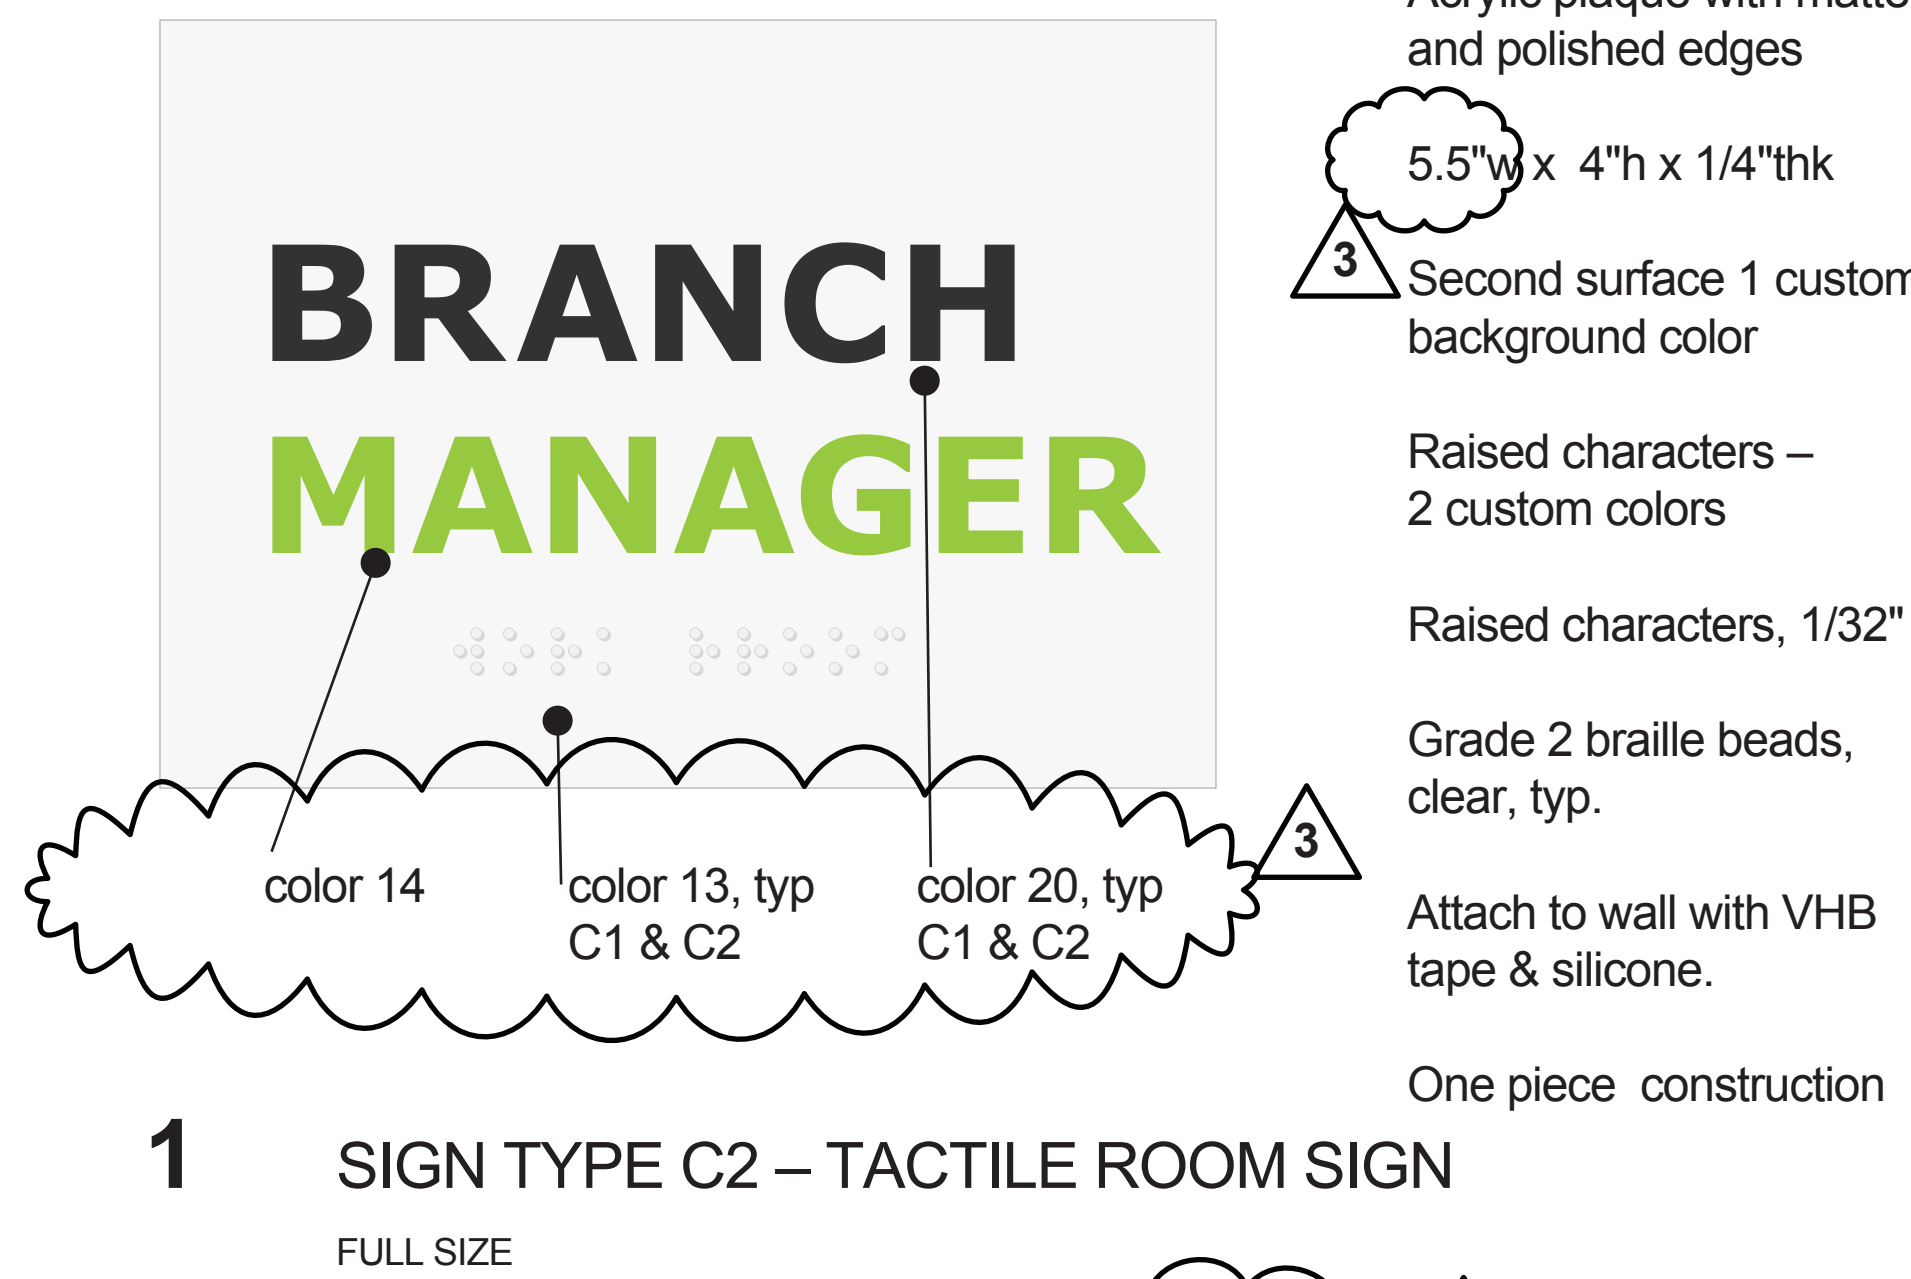

4 SIGN TYPE C4, C6, C8 – RESTROOM WALL SIGN
FULL SIZE

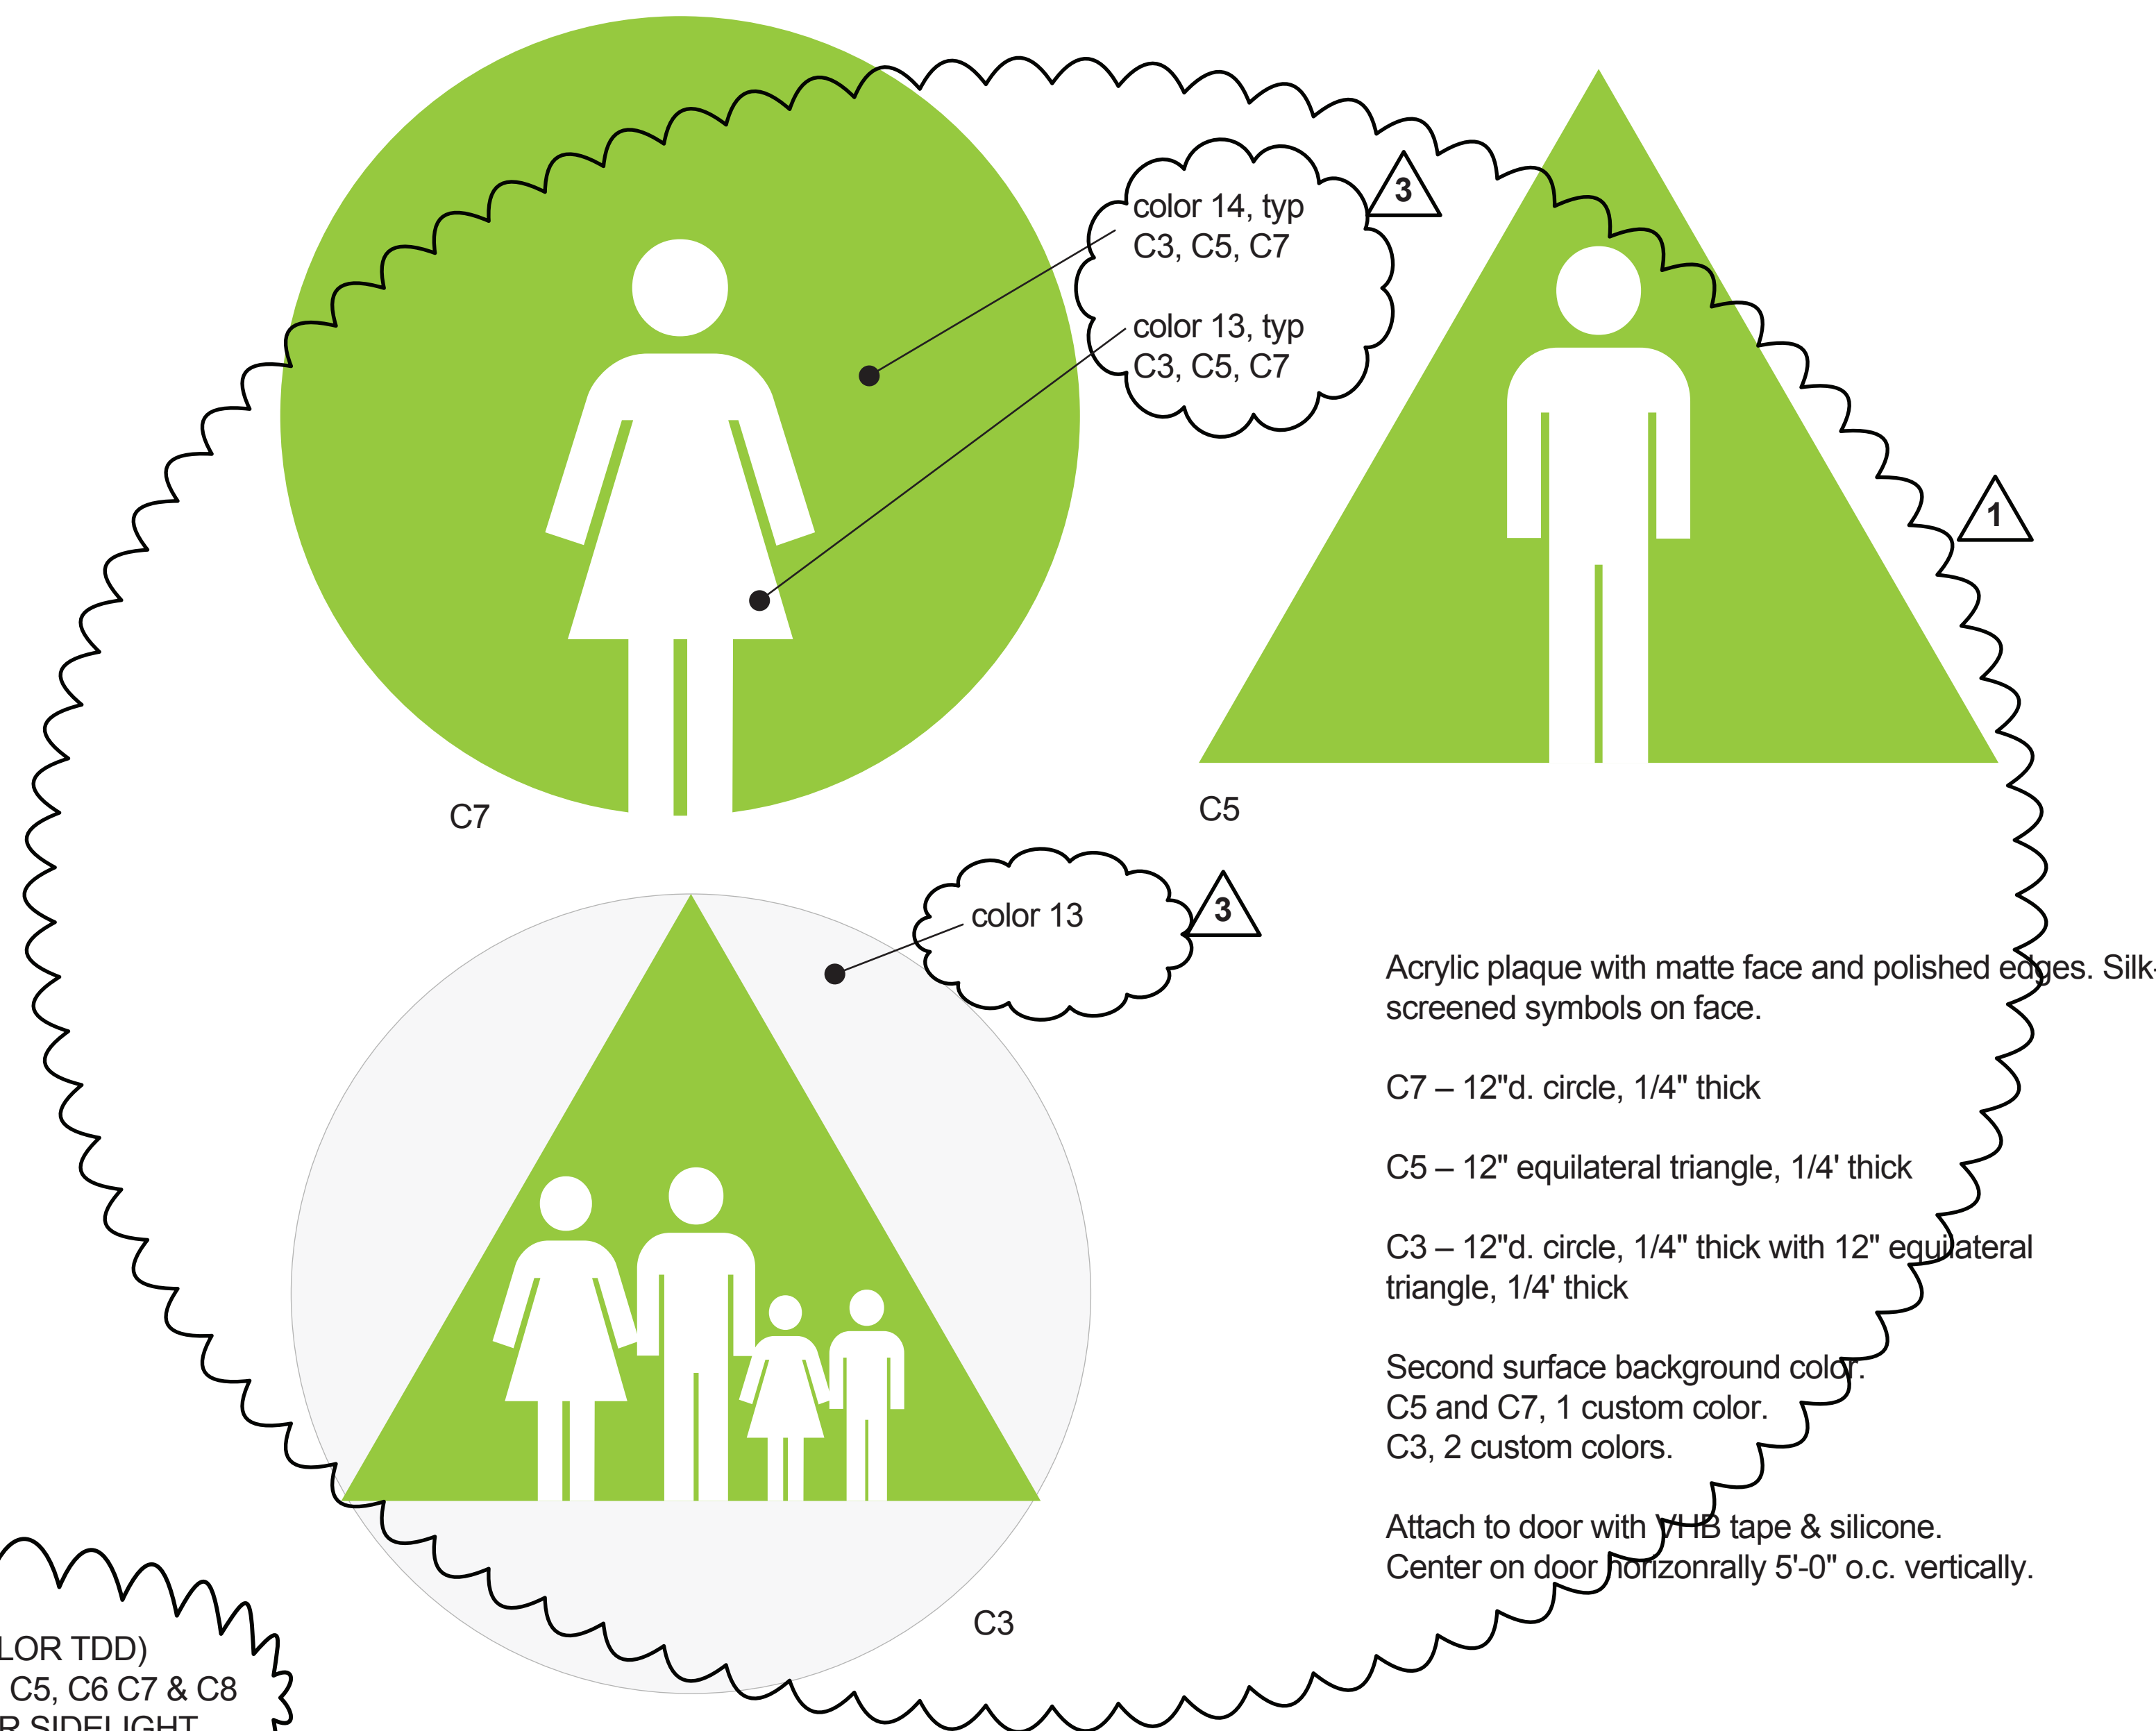

NOTE: ADD VDC FILM (CUSTOM COLOR TDD) WHERE SIGN TYPES C1, C2, C3, C4, C5, C6 C7 & C8 ARE MOUNTED ON GLASS DOOR OR SIDELIGHT

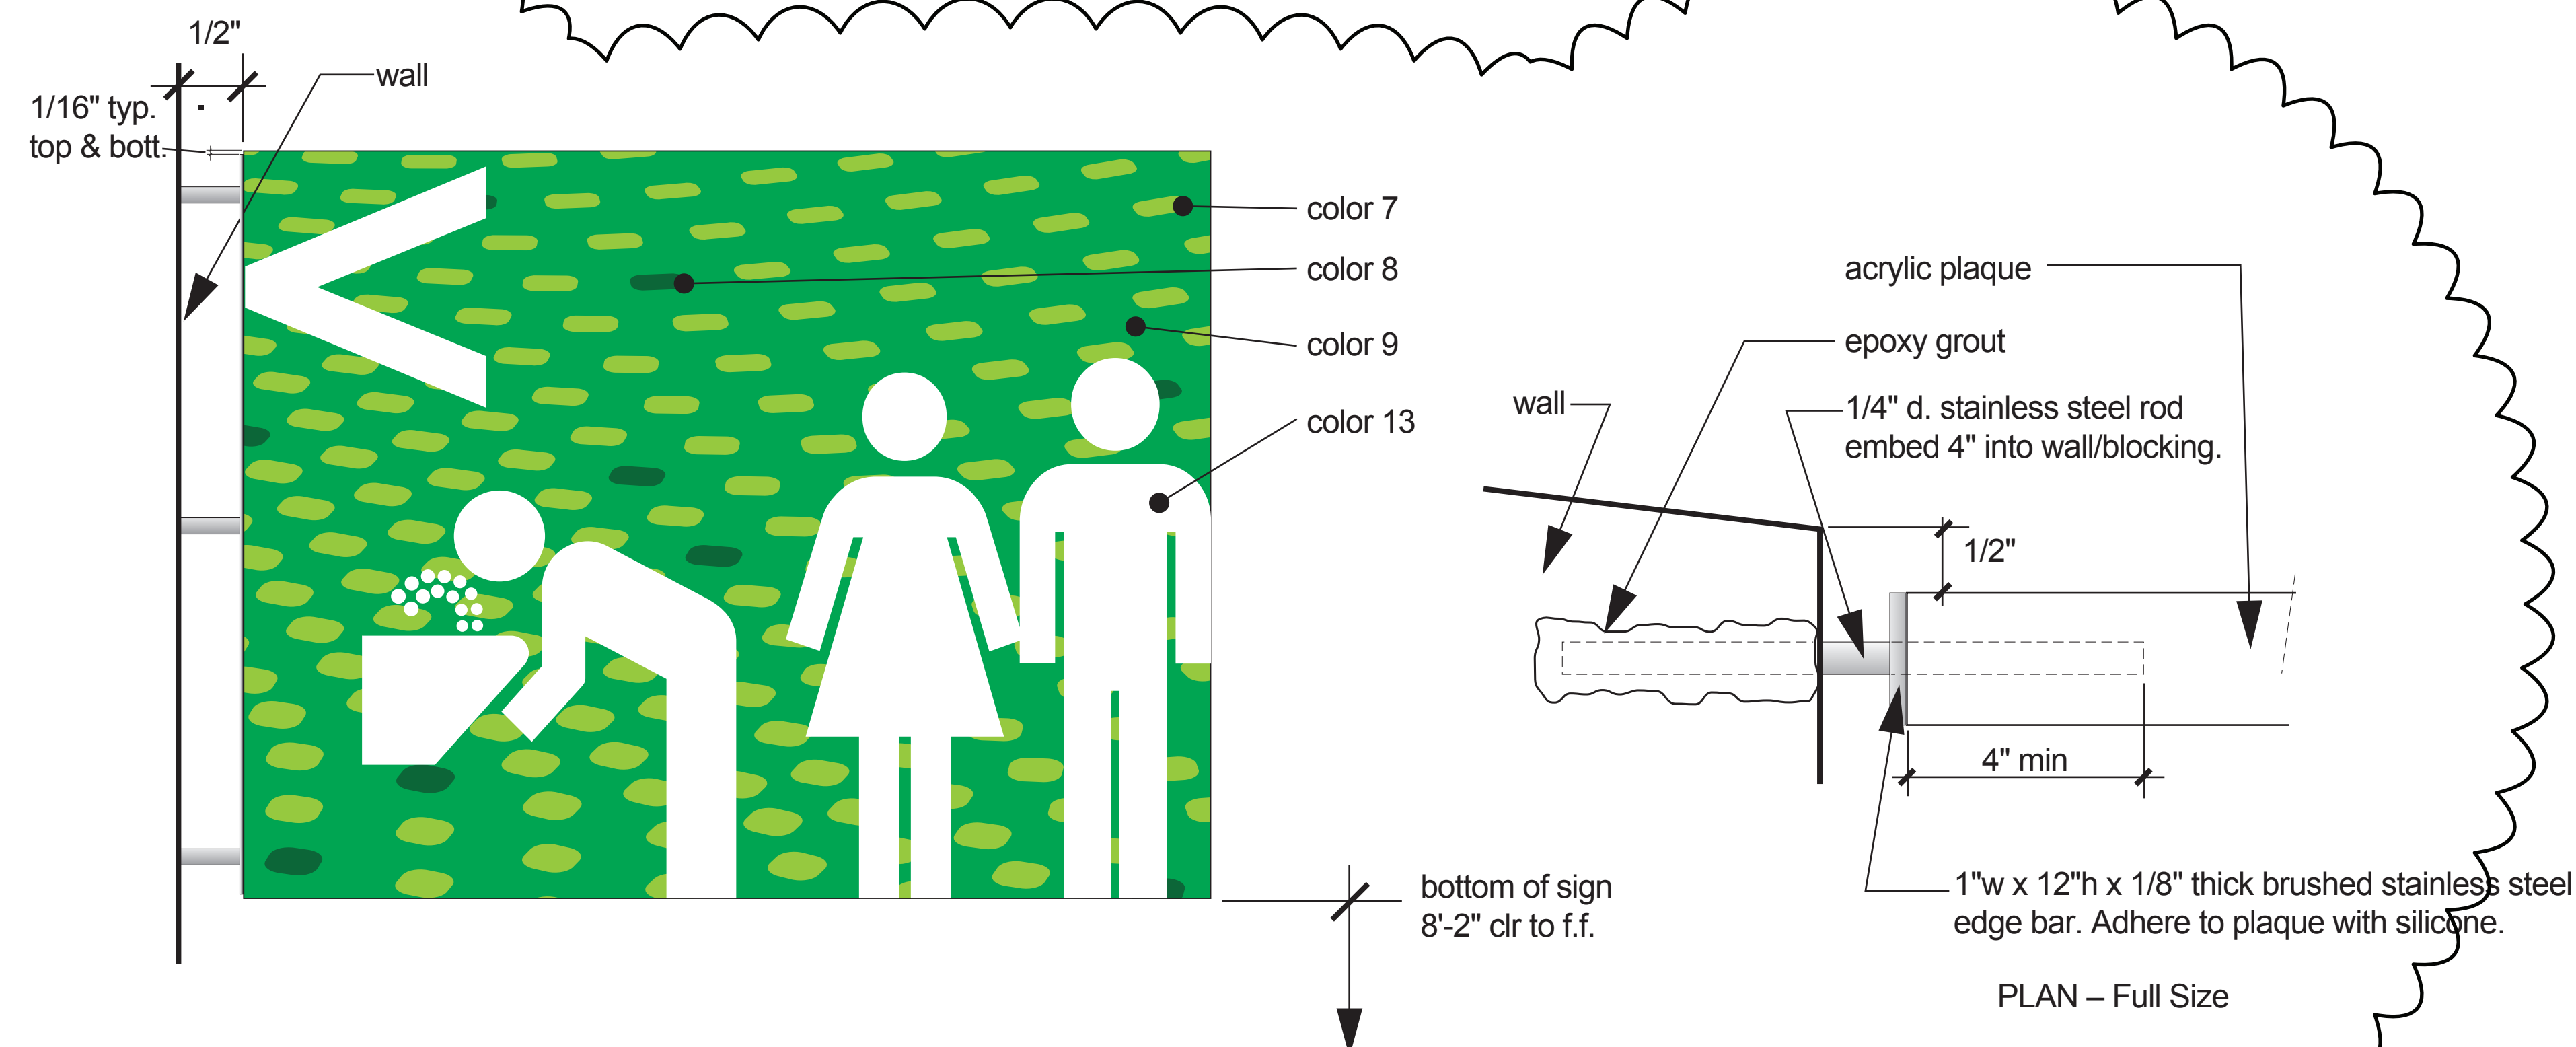

NOTE: SEE SHEET G9 FOR MOUNTING HEIGHTS FOR SIGN TYPES C1, C2, C3, C4, C5, C6 C7 & C8.




| NO. | DATE | BY | DESCRIPTION |
|-----------|----------|----|--------------|
| 1 | 07/16/12 | | BULLETIN 1 |
| 2 | 06/21/12 | | PLAN CHECK 2 |
| 3 | 05/07/12 | | PLAN CHECK 1 |
| 4 | 03/06/12 | | ADDENDUM 3 |
| 5 | 02/21/12 | | ADDENDUM 2 |
| REVISIONS | | | |

check out

3form (Chroma reflect with custom color on back of letter) dimensional cut out letters. 9" high and 1" thick. Attach to wall with undersize backer 3/16" thick. Attach with VHB tape and silicone.
2 custom colors.


1 SIGN TYPES A9 – SELF CHECK OUT ID

1/4"=1'-0"

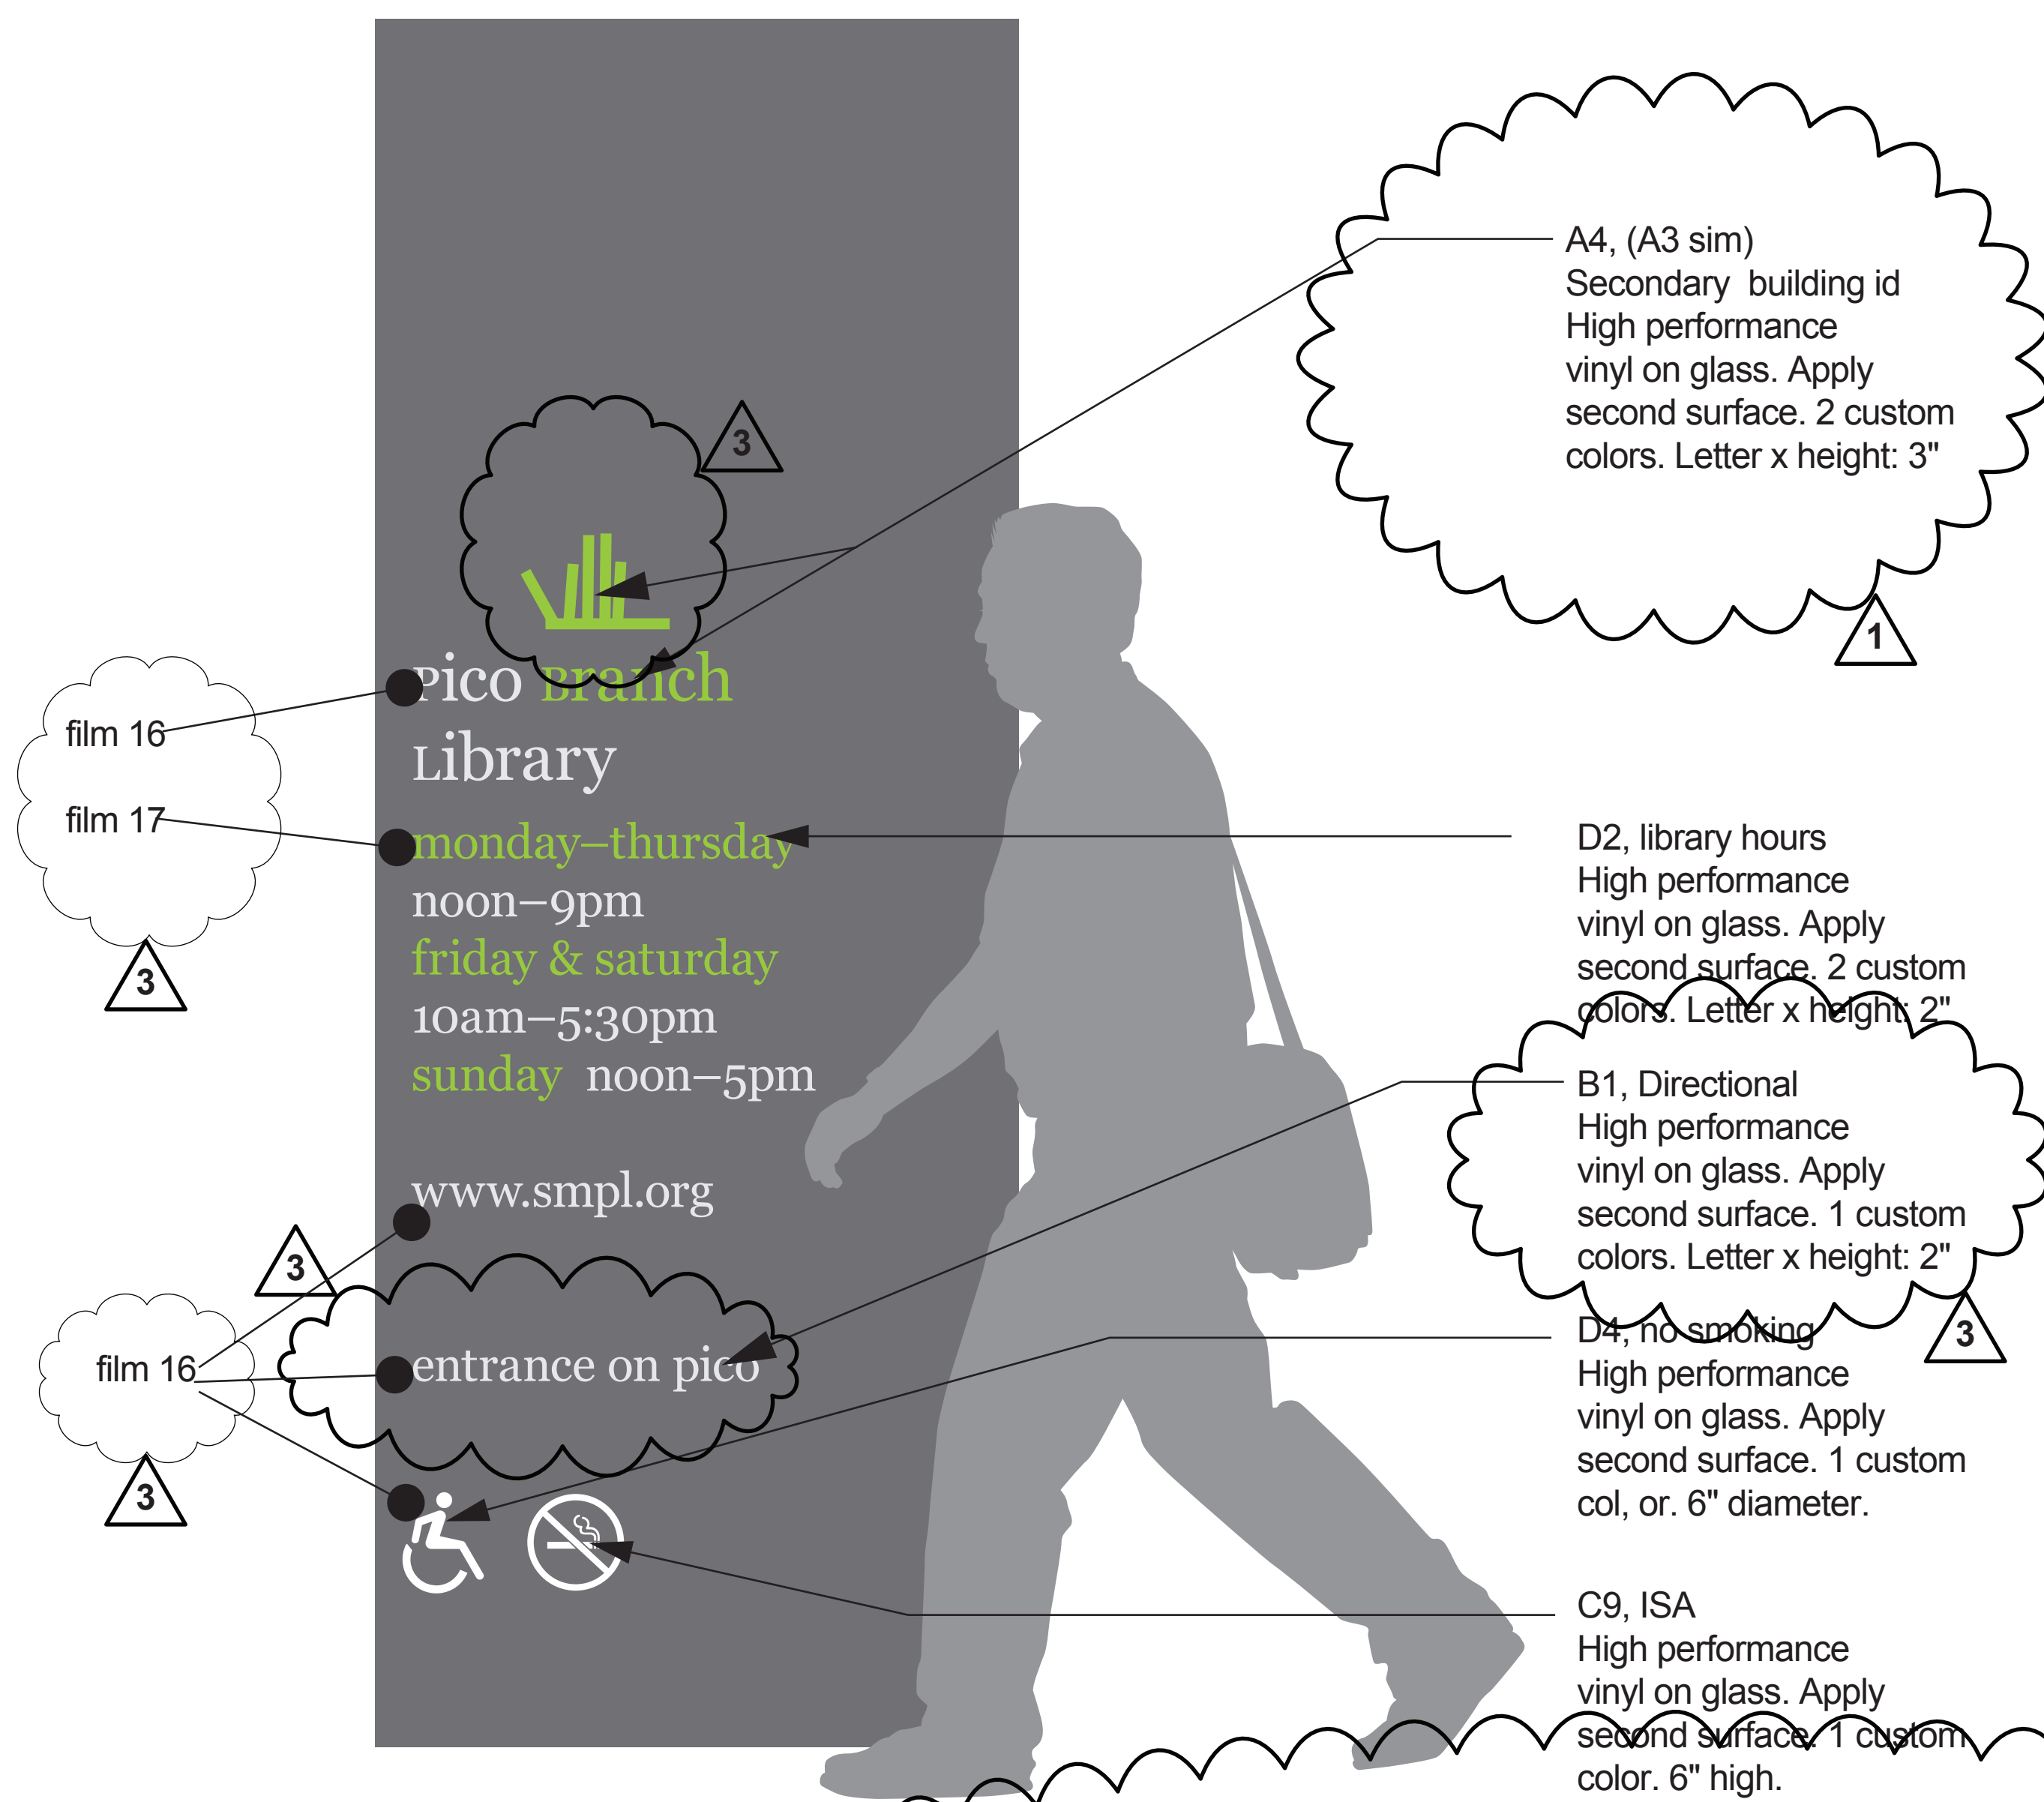

2 SIGN TYPES A4 (A3 SIM) – Main building ID North, C9 – ISA SYMBOL, D1 – LIBRARY HOURS & D4 – NO SMOKING

1/2"=1'-0"

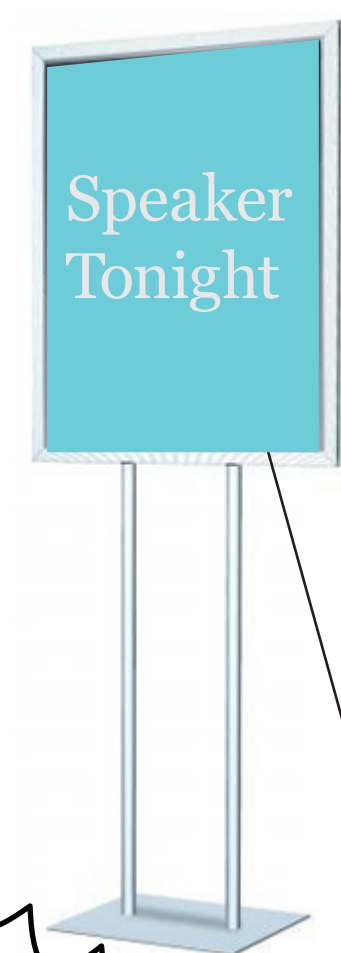


D6
Value Line Pedestal Sign Stand
Designed with heavy duty extruded alloy
Can display 1 or 2 posters 22" wide x 28" high
Sign frame orientation: vertical (portrait)
overall height: 60"
Finish: silver
1/4" top slot opening in sign frame used for poster insertion
Sign frame is connected to the base with a double pole design
Base design: rectangle
Overall approximate sign holder weight: 13 lbs
Suitable for indoor use

Paper insert. Template designed by Graphics Consultant.

4 SIGN TYPES D6, D7 & D8 – INFORMATION HOLDERS

NTS

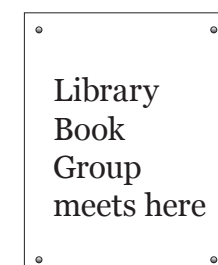

D7
Clear acrylic plaques with strong magnets. See www.lucitetombstones.com
item # 0371CSTM "Magnetic Sandwich"

8.5"w x 11"h x 1" total thk

Insert is changeable. first round typeset and printed by Newsom Design

Quantity: 6


Paper insert. Template designed by Graphics Consultant.

D8
Door message holder. Existing product in black powder-coated steel with stainless steel wire hook and ball. ASI Signage Innovations, 800-274-7732




3 SIGN TYPES A7 (A8 SIM) and D2 – SELF CHECK OUT ID

NTS

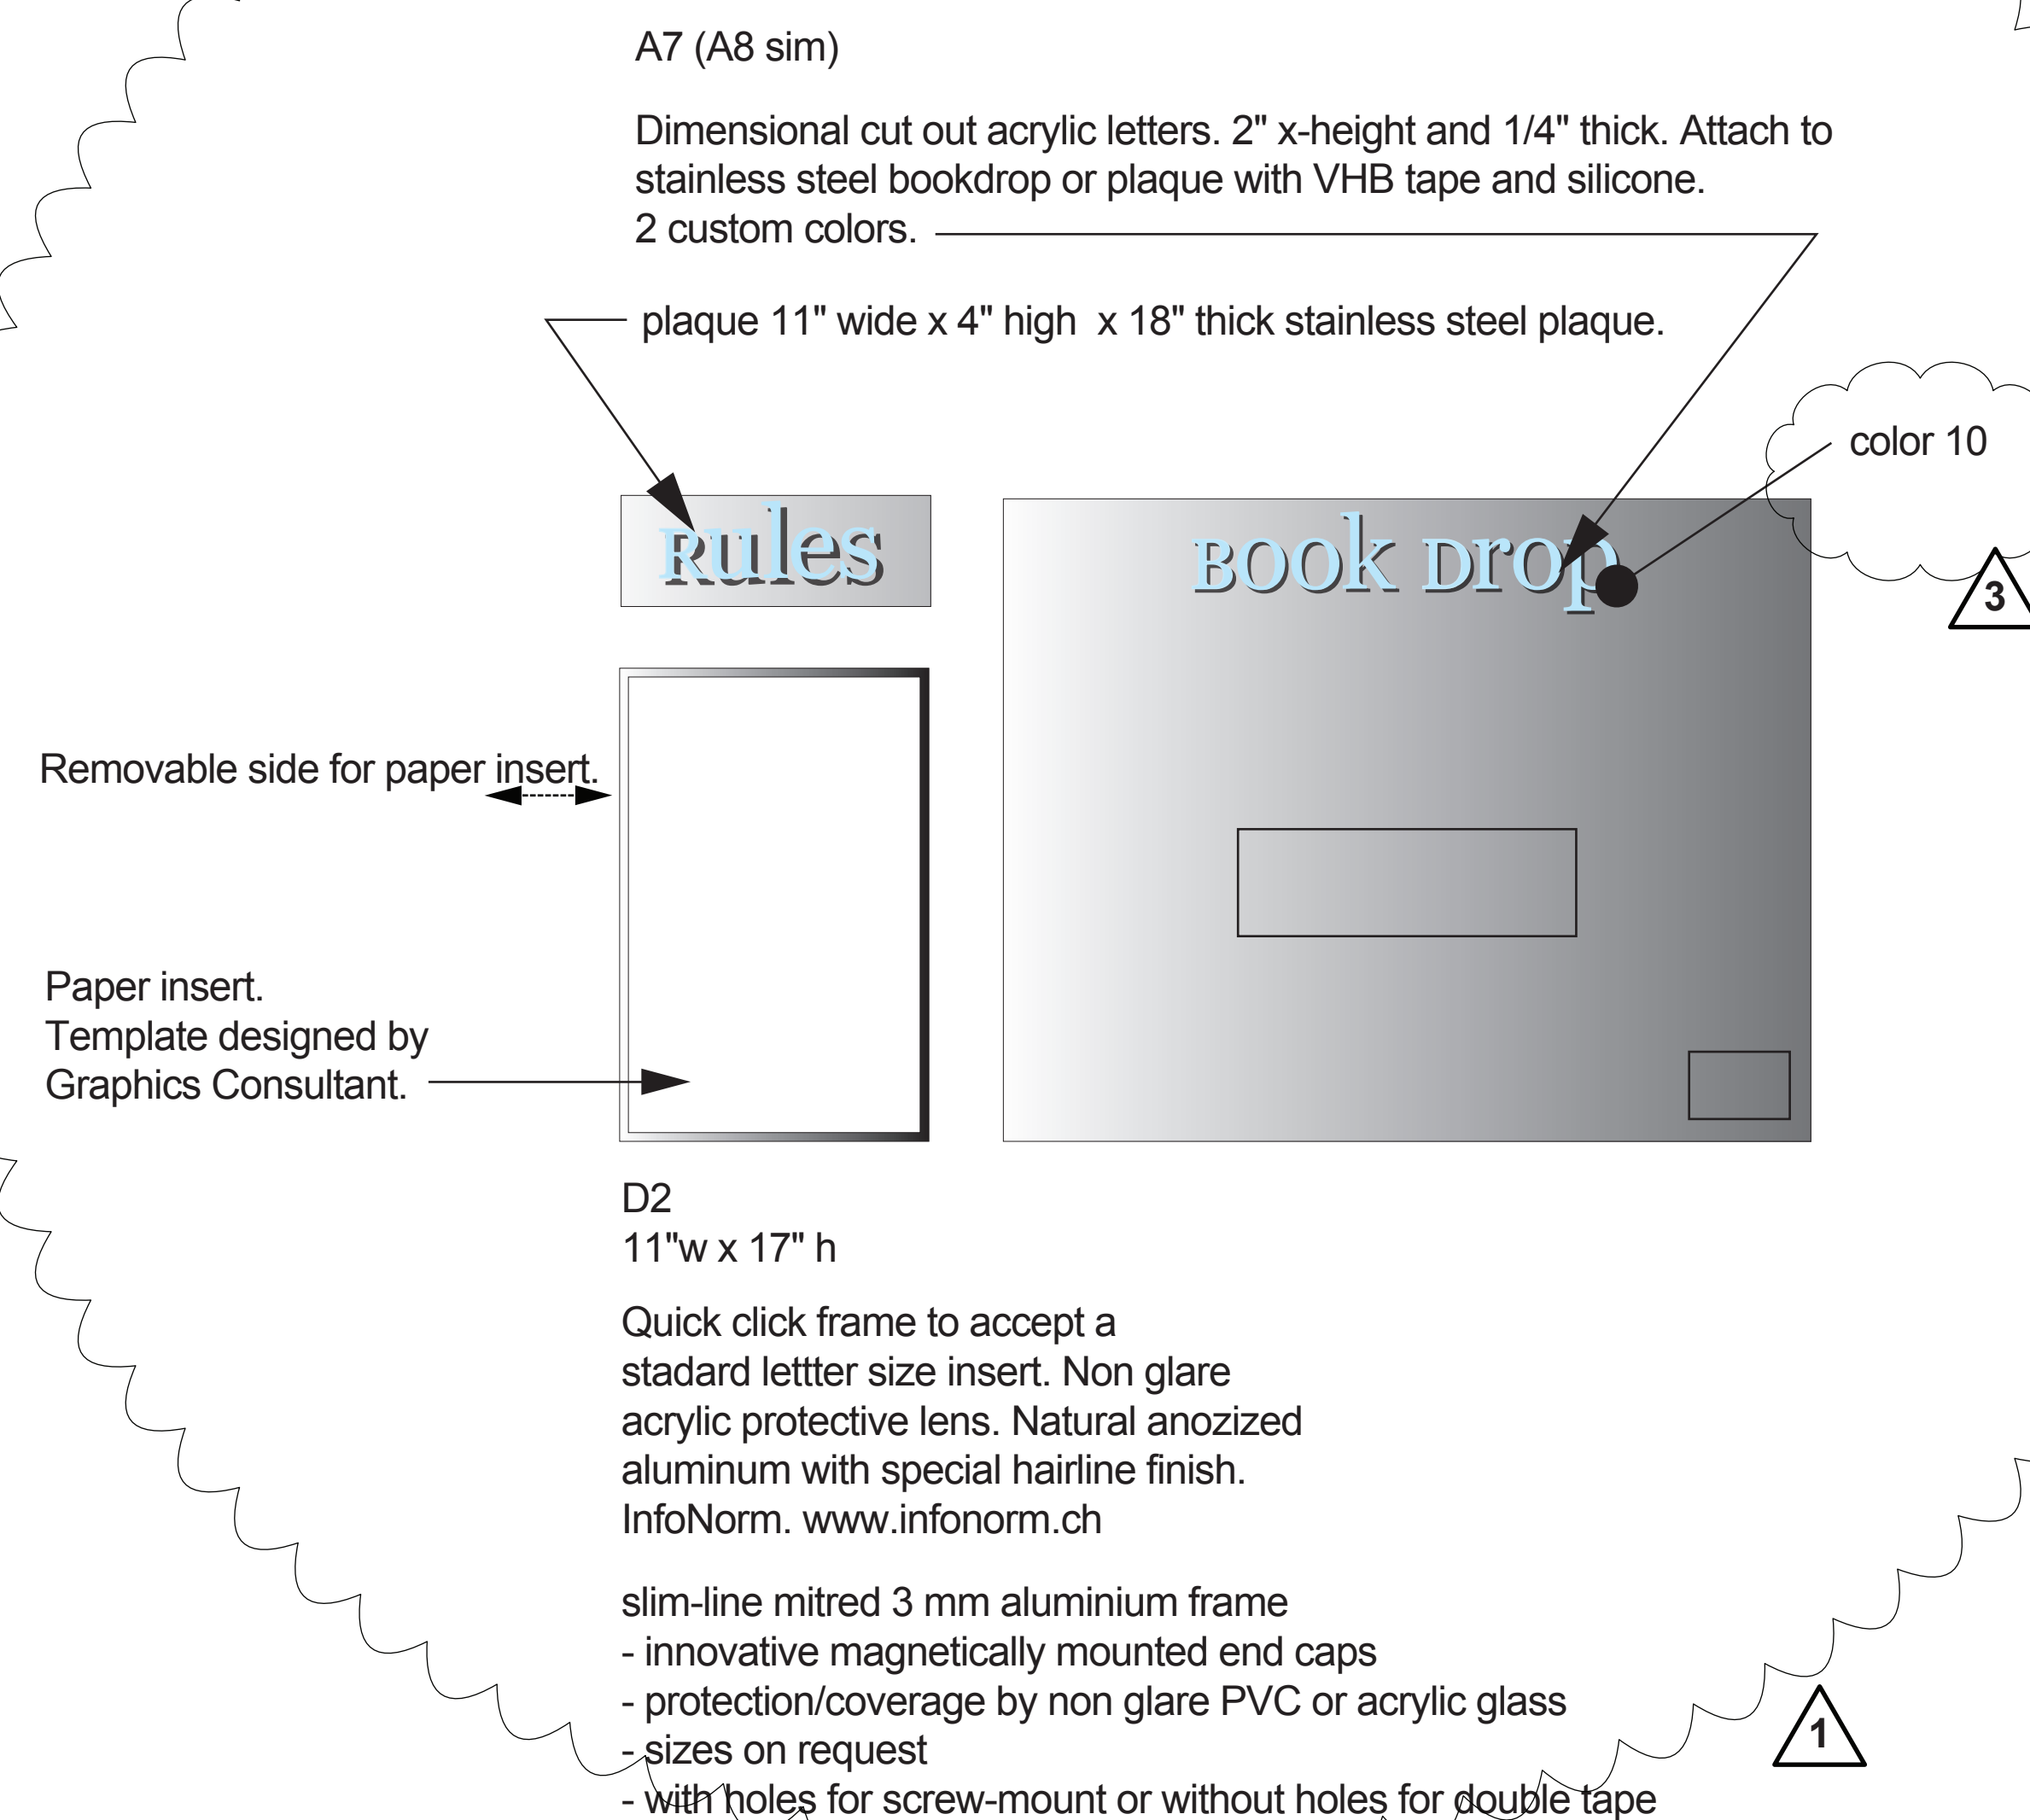

5 SIGN TYPES D5 – ART DEDICATION PLAQUE

1/4"=1'-0"



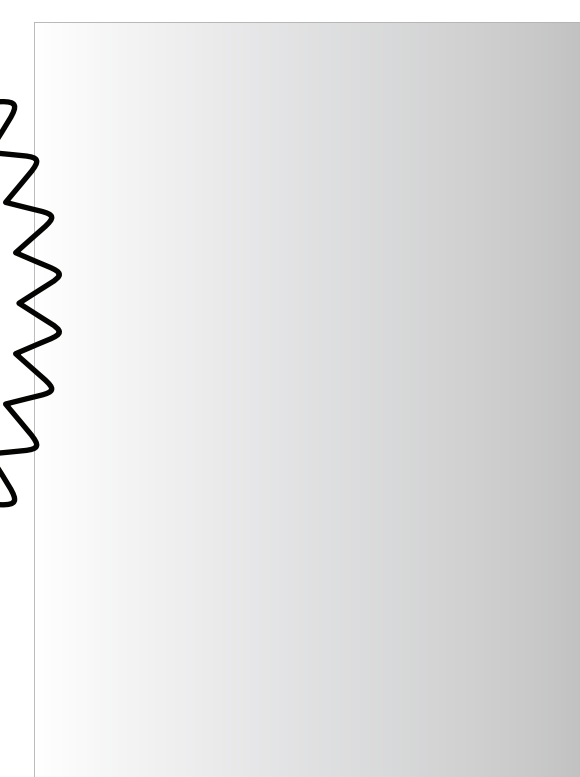


Stainless steel plaque
12"w x 16"h x 1/8"thk
Brush finish #5, horizontal direction
Silkscreened graphics – custom color, color 12
Quantity: 1
Mounting location and height TBD in field with Graphic Designer.

Copy TBD.




| NO. | DATE | BY | DESCRIPTION |
|-----|----------|----|--------------|
| 1 | 07/16/12 | | BULLETIN 1 |
| 2 | 06/21/12 | | PLAN CHECK 2 |
| 3 | 05/07/12 | | PLAN CHECK 1 |
| 4 | 03/06/12 | | ADDENDUM 3 |
| 5 | 02/21/12 | | ADDENDUM 2 |

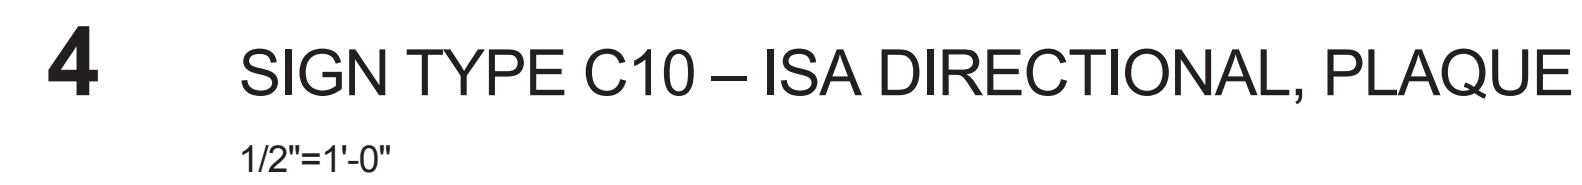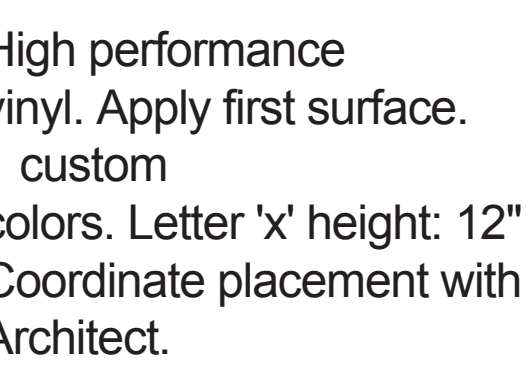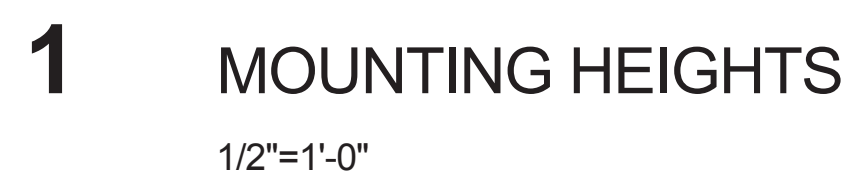

All designs, ideas, arrangements and plans indicated by these drawings are the property and copyright of the Architect and shall neither be used on any other work nor be disclosed to any other person for any use whatsoever without written permission.

Koning Eizenberg Architecture and/or its principals and employees waives any and all liability or responsibility for problems that may occur when these plans, drawings, specifications, and/or designs are followed without the professional's guidance with ambiguities, or conflicts which are alleged.

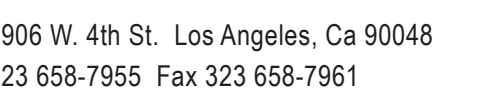NEW SOM
DESIGN

CONSULTANT



1437 4TH STREET, SUITE 300
SANTA MONICA, CA 90401
TEL. (310) 458-2205
FAX. (310) 399-1541
architecture@smgov.net

DATE : _____ 20____
SUBMITTED BY : _____

DATE : _____ 20 ____

APPROVED BY :
Miriam Mulder,
Architecture Services Manager

CITY OF SANTA MONICA
DEPARTMENT OF PUBLIC WORKS

REVIEWED BY: DATE: _____ 20 ____

REVIEWED BY: DATE: 20

REVIEWED BY: DATE: 20

ITY CLIENT

| | | | |
|-----------|----------|----|--------------|
| | | | |
| | | | |
| | | | |
| | | | |
| 3 | 07/16/12 | | BULLETIN 1 |
| | 06/21/12 | | PLAN CHECK 2 |
| | 05/07/12 | | PLAN CHECK 1 |
| 2 | 03/06/12 | | ADDENDUM 3 |
| 1 | 02/21/12 | | ADDENDUM 2 |
| NO | DATE | BY | DESCRIPTION |
| REVISIONS | | | |

ISSUE

100% CONSTRUCTION DOCUMENTS

DATE
06/21/2012

DRAWING NO. **6693**

SHEET TITLE

ELEVATION & DETAILS

SHEET NO.


G9


$$1/2'' = 1' - 0''$$



film E

$$1/2'' = 1'-0''$$

VDC vinyl film pattern applied to painted drywall.
Assume 125sf of area at each location. 4-5 custom colors per location.
High performance. Final graphic pattern TBD. Pattern different at each location.

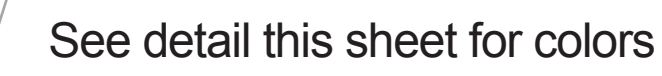

NTS

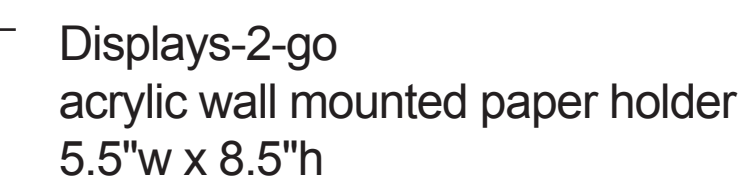

6"=1'-0"



| | | | |
|-----|----------|----|--------------|
| | | | |
| | | | |
| 3 | 07/16/12 | | BULLETIN 1 |
| | 06/21/12 | | PLAN CHECK 2 |
| | 05/07/12 | | PLAN CHECK 1 |
| 2 | 03/06/12 | | ADDENDUM 3 |
| 1 | 02/21/12 | | ADDENDUM 2 |
| NO. | DATE | BY | DESCRIPTION |

REVISIONS