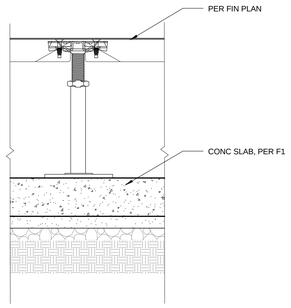

F2	CONC	-	-	-	-	
TYPE	STRUCTURE	FIRE RATING	IIC RATING	STC RATING	INSUL. TYPE	APPROVAL/REMARKS

RAISED ACCESS F2

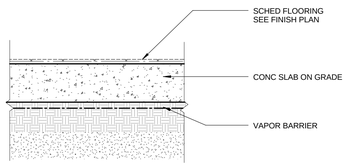

F1A	CONC					
F1	CONC	N/A	N/A	N/A	N/A	
TYPE	STRUCTURE	FIRE RATING	IIC RATING	STC RATING	INSUL. TYPE	APPROVAL/REMARKS

SLAB ON GRADE F1

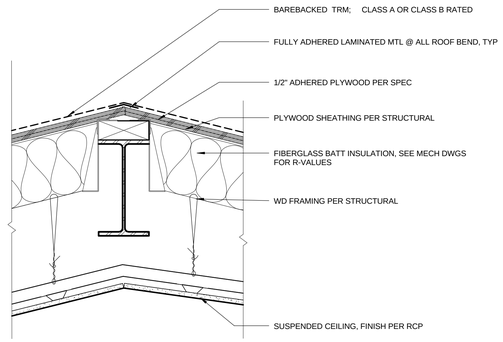

R2	STL/CONC	A OR B	-	-	-	ICC-ESR-1157
TYPE	STRUCTURE	FIRE RATING	IIC RATING	STC RATING	INSUL. TYPE	APPROVAL/REMARKS

THERMOPLASTIC ROOFING R2

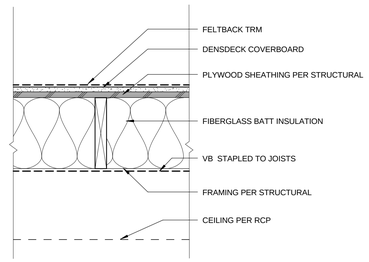

R1	STL/CONC	A OR B	-	-	-	ICC-ESR-1157
TYPE	STRUCTURE	FIRE RATING	IIC RATING	STC RATING	INSUL. TYPE	APPROVAL/REMARKS

THERMOPLASTIC ROOFING R1

NOTES:
PROVIDE MINIMUM OF 2 LAYERS OF GRADE D PAPER BETWEEN PLYWOOD SHEAR WALL AND EXTERIOR LATH.

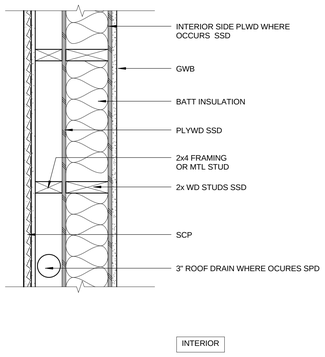

EXTERIOR FURRED OUT WALL H

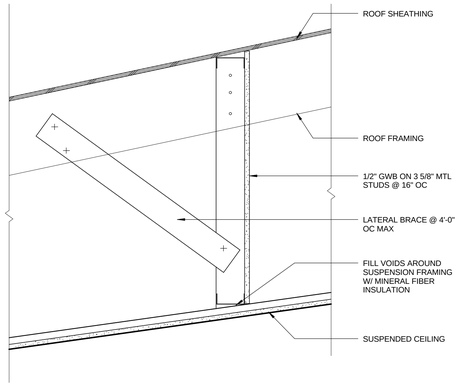

ATTIC DRAFTSTOPPING DS

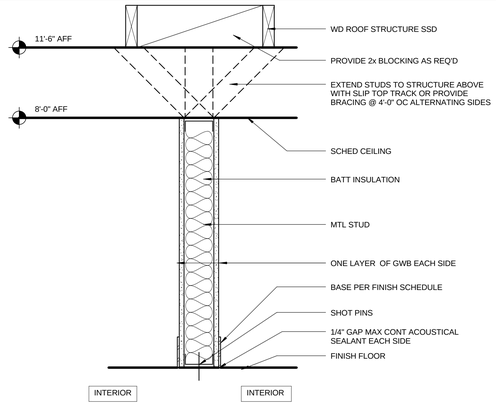

INTERIOR MTL PARTITION C

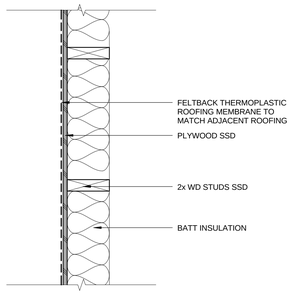

EXTERIOR TRM WALL J

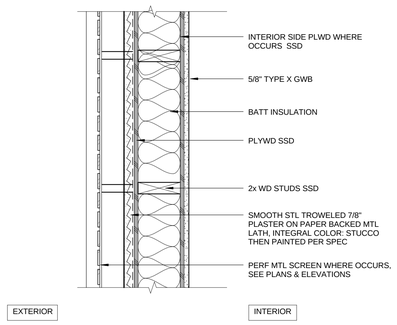

WALL TYPE G1 IS SAME CONSTRUCTION AND REQUIRES
1 HR RATING PER TABLE 702, ITEM 15.1.3

1 HR/ EXTERIOR STUCCO WALL G

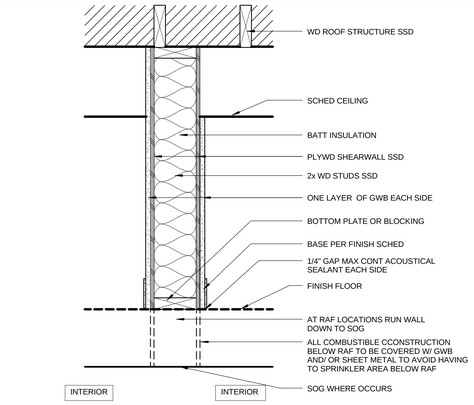

INTERIOR LOAD BEARING PARTITION E

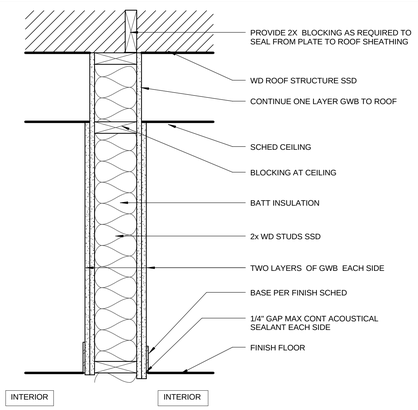

INTERIOR PARTITION B

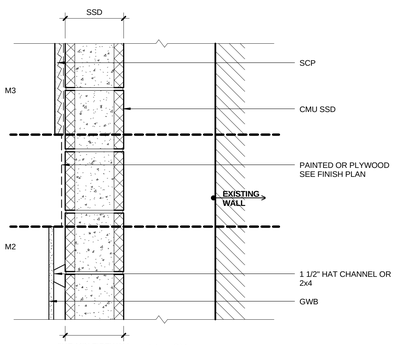

TABLE 720.1
2 HR WALL REQUIRES 4.2" MIN THICKNESS,
1 HR WALL REQUIRES 2.8" MIN THICKNESS

EXTERIOR MASONRY WALL M

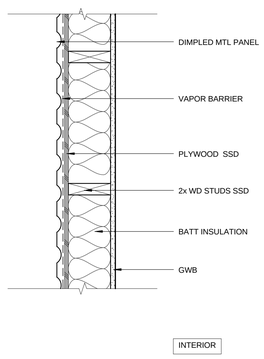

EXTERIOR MTL PANEL WALL F

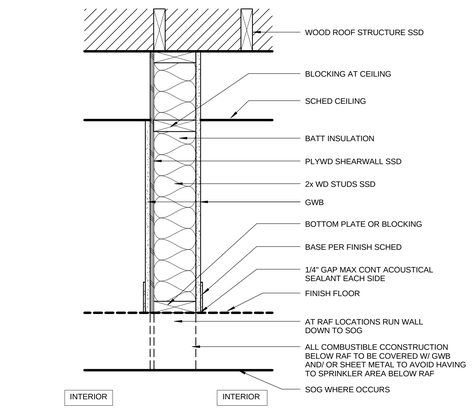

INTERIOR LOAD BEARING PARTITION D

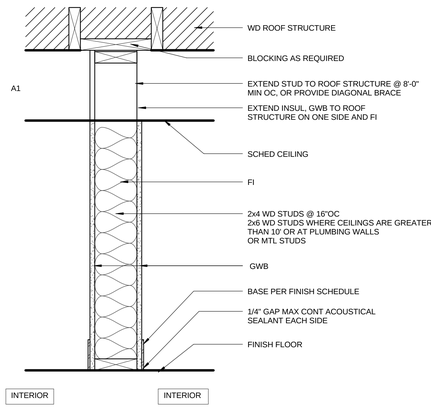

INTERIOR PARTITION A

PICO BRANCH LIBRARY

2201 Pico Blvd.
Santa Monica, CA 90404

PROJECT

KoningEizenbergArchitecture
1454 25th St, Santa Monica, CA 90404
310.828.6131 info@kearch.com
310.828.0719 fax www.kearch.com

ARCHITECT'S PROJECT NO.
1001

ARCHITECT

All designs, ideas, arrangements and plans indicated by these drawings are the property and copyright of the Architect and shall neither be used on any other work nor be disclosed to any other person for any use whatsoever without written permission.

Koning Eizenberg Architecture and/or its principals and employees waives any and all liability or responsibility for problems that may occur when these plans, drawings, specifications, and/or designs are followed without the professional's guidance with ambiguities, or conflicts which are alleged.

CONSULTANT

City of Santa Monica Architecture Services
1437 4TH STREET, SUITE 300
SANTA MONICA, CA 90401
TEL. (310) 458-2205
FAX. (310) 399-1541
architecture@smgov.net

SUBMITTED BY : DATE : _____ 20 __

APPROVED BY : DATE : _____ 20 __
Miriam Mulder,
Architecture Services Manager

CITY OF SANTA MONICA
DEPARTMENT OF PUBLIC WORKS

REVIEWED BY : DATE : _____ 20 __

REVIEWED BY : DATE : _____ 20 __

REVIEWED BY : DATE : _____ 20 __

CITY CLIENT

NO.	DATE	BY	DESCRIPTION
3	05/07/12		PLAN CHECK 1
2	03/06/12		ADDENDUM 3
1	02/21/12		ADDENDUM 2

REVISIONS

ISSUE
PLAN CHECK CORRECTIONS

DATE
05/07/2012

DRAWING NO.
6693

SHEET TITLE
WALL / ROOF / FLOOR ASSEMBLIES

SHEET NO.
A9.30

SHEET OF

DWG. NO. - -

TITLE OF PROJECT :