GENERAL NOTES

1. ELECTRICAL CONTRACTOR TO PROVIDE 120V CONNECTION TO ACTUATORS. LOW VOLTAGE TRANSFORMER TO BE PROVIDED BY DIV 23 CONTROLS.
2. COORDINATE WITH MECHANICAL EXACT LOCATION OF EQUIPMENT. PRE-INSTALLATION POWER & TERMINATION REQUIREMENTS.
3. THE DESIGN OF THE UNDERFLOOR AIR DISTRIBUTION SYSTEM IS BASED ON A SEALED, AIRTIGHT UNDERFLOOR PLENUM. ALL CONSTRUCTION JOINTS AT PLENUM BOUNDARIES AND PLENUM DIVIDING PARTITIONS SHALL BE SEALED AIRTIGHT. ALL PENETRATIONS FOR PIPES, CONDUIT AND OTHER SERVICES SHALL BE SEALED AIRTIGHT. PLENUMS SHALL BE TESTED FOR LEAKAGE PER THE COMMISSIONING SPECIFICATIONS. PLENUMS THAT DO NOT MEET THE LEAKAGE CRITERIA PER THE SPECIFICATIONS SHALL BE RESEALED AND RETESTED UNTIL THEY PASS. REFER TO THE ARCHITECTURAL DRAWINGS FOR CONSTRUCTION DETAILS AND ADDITIONAL INFORMATION.
4. FOR ADDITIONAL INFORMATION ON LOW VOLTAGE SYSTEMS (IT & AV) SEE LOW VOLTAGE CONSULTANT DRAWINGS.
5. ALL OUTDOOR EQUIPMENT TO BE IN A NEMA 3R WEATHERPROOF ENCLOSURE.

SHEET NOTES

1. CONTRACTOR TO PROVIDE (1)4"C.O. TO STUB INTO ELECTRICAL ROOM FOR PV CONNECTIONS. CONFIRM CONDUIT REQUIREMENTS WITH PV VENDOR.

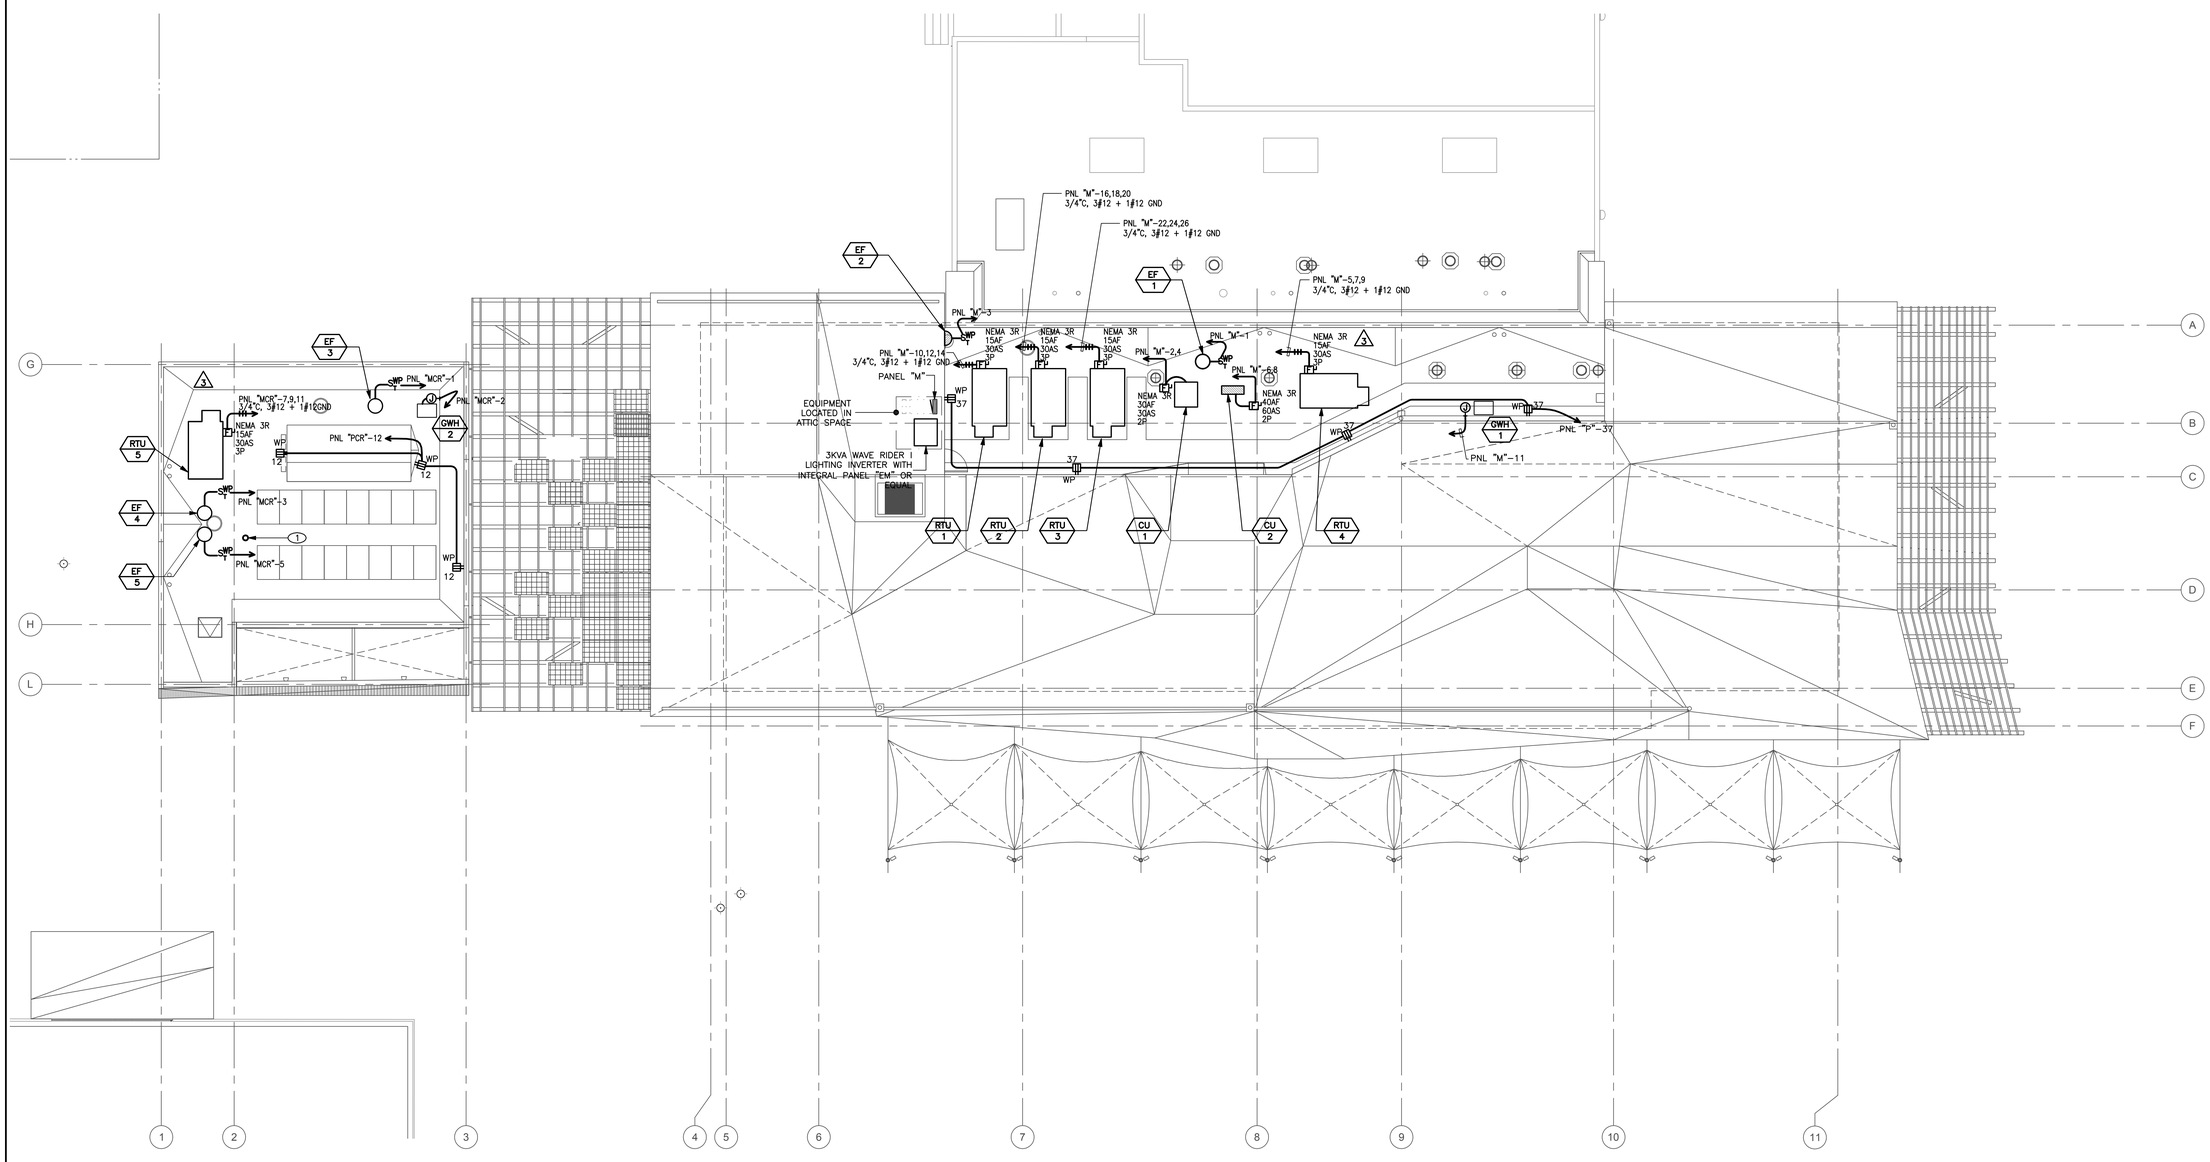

1 **POWER ROOF PLAN**
SCALE: 1/8"=1'-0"

0 4' 8' 16'

PICO BRANCH LIBRARY

2201 Pico Blvd.
Santa Monica, CA 90404

PROJECT

KoningEizenbergArchitecture
1454 25th St, Santa Monica, CA 90404

310.828.6131 info@kearch.com
310.828.0719 fax www.kearch.com

ARCHITECT'S PROJECT NO.
1001

ARCHITECT

All designs, ideas, arrangements and plans indicated by these drawings are the property and copyright of the Architect and shall neither be used on any other work nor be disclosed to any other person for any use whatsoever without written permission.

Koning Eizenberg Architecture and/or its principals and employees waives any and all liability or responsibility for problems that may occur when these plans, drawings, specifications, and/or designs are followed without the professional's guidance with ambiguities, or conflicts which are alleged.

REGISTERED PROFESSIONAL ENGINEER
JACOB CHAN
No. E13359
Exp. 12-31-12
ELECTRICAL
STATE OF CALIFORNIA

GLUMAC
617 W. 7th Street, Suite 500
Los Angeles, CA 90017
T. 213.239.8866 F. 213.239.8816
www.glumac.com
Job No.: 06.11.00192
Contact: E. LEE

engineers for a sustainable future™

CONSULTANT

City of Santa Monica
Architecture Services

1437 4TH STREET, SUITE 300
SANTA MONICA, CA 90401
TEL. (310) 458-2205
FAX. (310) 399-1541
architecture@smgov.net

SUBMITTED BY : DATE : 20

APPROVED BY : DATE : 20
Miriam Mulder,
Architecture Services Manager

CITY OF SANTA MONICA
DEPARTMENT OF PUBLIC WORKS

REVIEWED BY : DATE : 20

REVIEWED BY : DATE : 20

REVIEWED BY : DATE : 20

CITY CLIENT

NO.	DATE	BY	DESCRIPTION
1	05/07/12		PLAN CHECK 1
2	03/06/12		ADDENDUM 3
1	02/21/12		ADDENDUM 2

REVISIONS

ISSUE
PLAN CHECK CORRECTIONS

DATE
05/07/2012

DRAWING NO. **6693**

SHEET TITLE
POWER ROOF PLAN

SHEET NO.
E2.1

SHEET OF

DWG NO. -

TITLE OF PROJECT: