SHEET OF

DWG NO. -

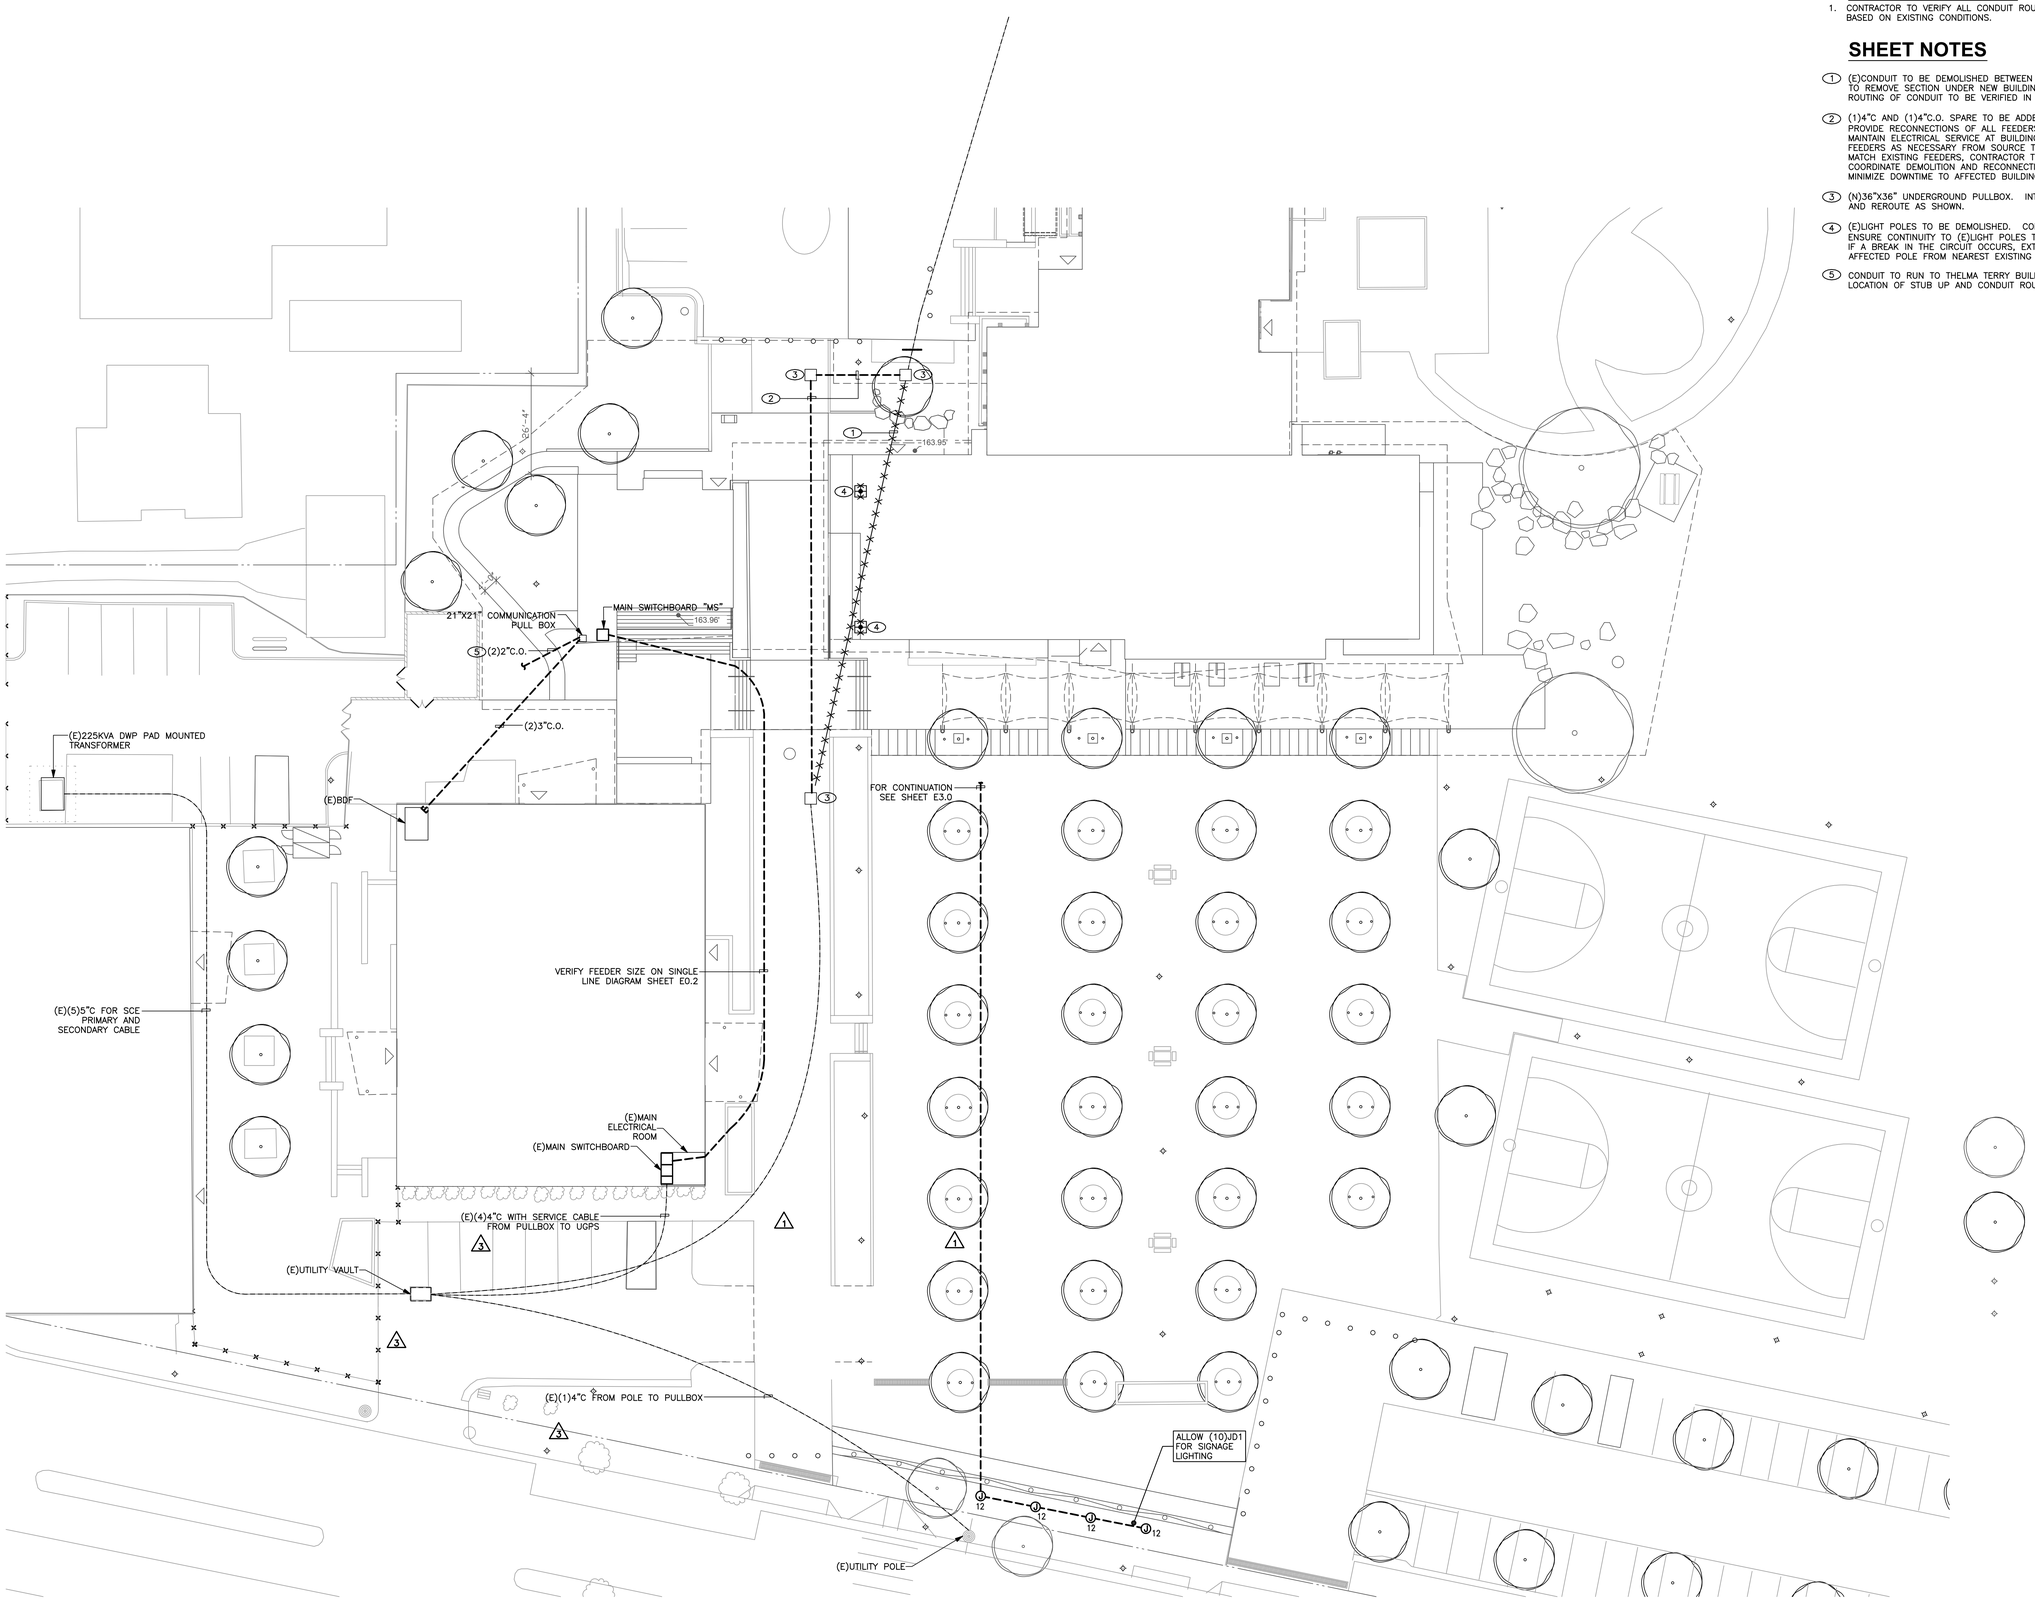

1 ELECTRICAL SITE PLAN

SCALE: 1/16"=1'-0"

0 8' 16' 32'

N

GENERAL NOTES

1. CONTRACTOR TO VERIFY ALL CONDUIT ROUTING IN FIELD BASED ON EXISTING CONDITIONS.

SHEET NOTES

1. (E)CONDUIT TO BE DEMOLISHED BETWEEN NEW PULL BOXES TO REMOVE SECTION UNDER NEW BUILDING FOOTING. EXACT ROUTING OF CONDUIT TO BE VERIFIED IN FIELD.
2. (1)4"C AND (1)4"C.O. SPARE TO BE ADDED AS SHOWN. PROVIDE RECONNECTIONS OF ALL FEEDERS AT (E)PULLBOX TO MAINTAIN ELECTRICAL SERVICE AT BUILDING. PULL NEW FEEDERS AS NECESSARY FROM SOURCE TO BUILDING TO MATCH EXISTING FEEDERS, CONTRACTOR TO FIELD VERIFY. COORDINATE DEMOLITION AND RECONNECTION WITH CITY TO MINIMIZE DOWNTIME TO AFFECTED BUILDINGS. 3
3. (N)36"X36" UNDERGROUND PULLBOX. INTERCEPT (E)CONDUIT AND REROUTE AS SHOWN.
4. (E)LIGHT POLES TO BE DEMOLISHED. CONTRACTOR TO ENSURE CONTINUITY TO (E)LIGHT POLES THAT ARE REMAINING. IF A BREAK IN THE CIRCUIT OCCURS, EXTEND CIRCUIT TO AFFECTED POLE FROM NEAREST EXISTING POLE TO REMAIN.
5. CONDUIT TO RUN TO THELMA TERRY BUILDING. VERIFY EXACT LOCATION OF STUB UP AND CONDUIT ROUTING WITH OWNER.

PICO BRANCH LIBRARY

2201 Pico Blvd.
Santa Monica, CA 90404

PROJECT

KoningEizenbergArchitecture
1454 25th St, Santa Monica, CA 90404

310.828.6131 info@kearch.com
310.828.0719 fax www.kearch.com

ARCHITECT'S PROJECT NO.
1001

ARCHITECT

All designs, ideas, arrangements and plans indicated by these drawings are the property and copyright of the Architect and shall neither be used on any other work nor be disclosed to any other person for any use whatsoever without written permission.

Koning Eizenberg Architecture and/or its principals and employees waives any and all liability or responsibility for problems that may occur when these plans, drawings, specifications, and/or designs are followed without the professional's guidance with ambiguities, or conflicts which are alleged.

REGISTERED PROFESSIONAL ENGINEER JACOB OHM E 13353 ELECTRICAL STATE OF CALIFORNIA

GLUMAC
617 W. 7th Street, Suite 500
Los Angeles, CA 90017
T. 213.239.8866 F. 213.239.8816
www.glumac.com
Job No.: 06.11.00192
Contact: E. LEE

engineers for a sustainable future™

CONSULTANT

City of Santa Monica Architecture Services
1437 4TH STREET, SUITE 300
SANTA MONICA, CA 90401
TEL. (310) 458-2205
FAX. (310) 399-1541
architecture@smgov.net

SUBMITTED BY : DATE : 20

APPROVED BY : Miriam Mulder, Architecture Services Manager DATE : 20

CITY OF SANTA MONICA
DEPARTMENT OF PUBLIC WORKS

REVIEWED BY : DATE : 20

REVIEWED BY : DATE : 20

REVIEWED BY : DATE : 20

CITY CLIENT

NO.	DATE	BY	DESCRIPTION
3	05/07/12		PLAN CHECK 1
2	03/06/12		ADDENDUM 3
1	02/21/12		ADDENDUM 2

REVISIONS

ISSUE

PLAN CHECK CORRECTIONS

DATE
05/07/2012

DRAWING NO. **6693**

SHEET TITLE
ELECTRICAL SITE PLAN

SHEET NO.
E1.0

TITLE OF PROJECT