KEY NOTES

1. REMOVE FIRE ALARM DEVICES AND WIRING. 1B
2. ~~REMOVE PA SYSTEM SPEAKERS AND WIRING.~~ NIC 1A
3. ~~DUPLEX RECEPTACLES ARE TO BE REMOVED. INTERCONNECT OR SPLICE EXISTING WIRE FOR CIRCUIT CONTINUITY. PROVIDE/INSTALL JUNCTION BOX BLANK PLATE COVER.~~ NIC 1B

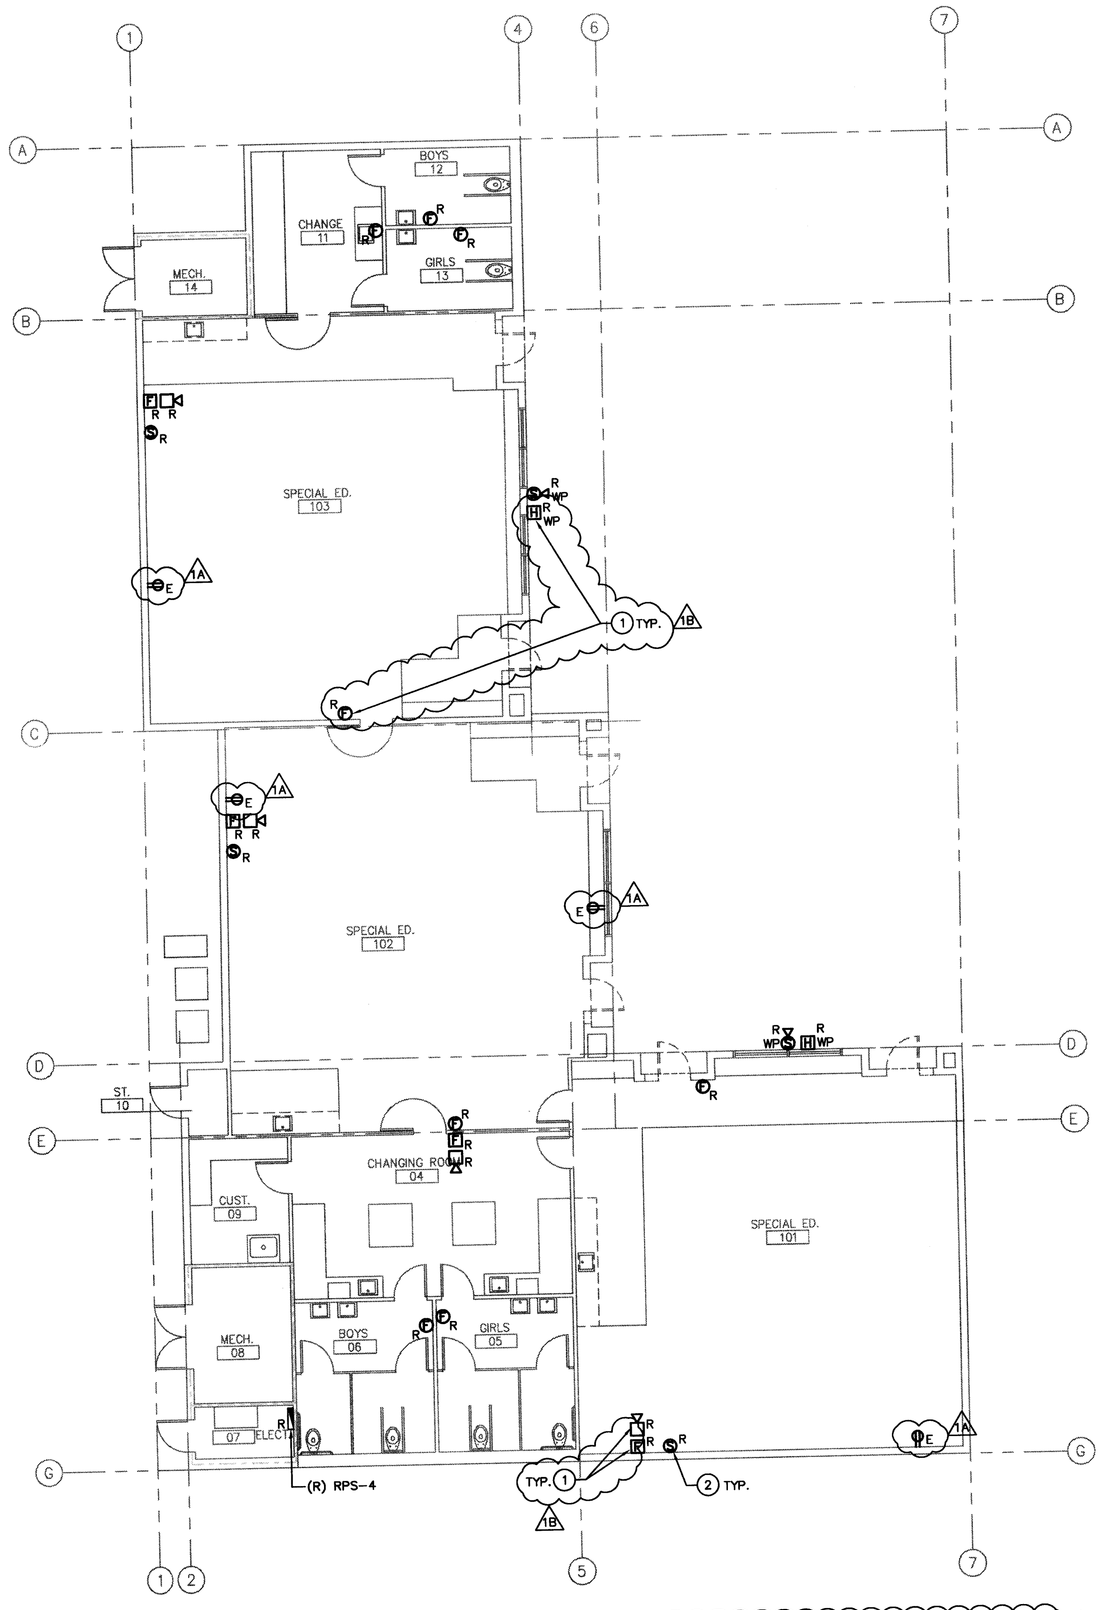

VOICE/DATA & PA SYSTEMS DEMOLITION SCOPE ARE NOT IN CONTRACT 1B

1B

N

BUILDING 4 - POWER & SIGNAL DEMOLITION PLAN 1/8"=1'-0" 2

KEY NOTES

1. REMOVE FIRE ALARM DEVICES AND WIRING. 1B
2. ~~REMOVE PA SYSTEM SPEAKERS AND WIRING.~~ NIC 1A
3. ~~DUPLEX RECEPTACLES ARE TO BE REMOVED. INTERCONNECT OR SPLICE EXISTING WIRE FOR CIRCUIT CONTINUITY. PROVIDE/INSTALL JUNCTION BOX BLANK PLATE COVER.~~ NIC 1B

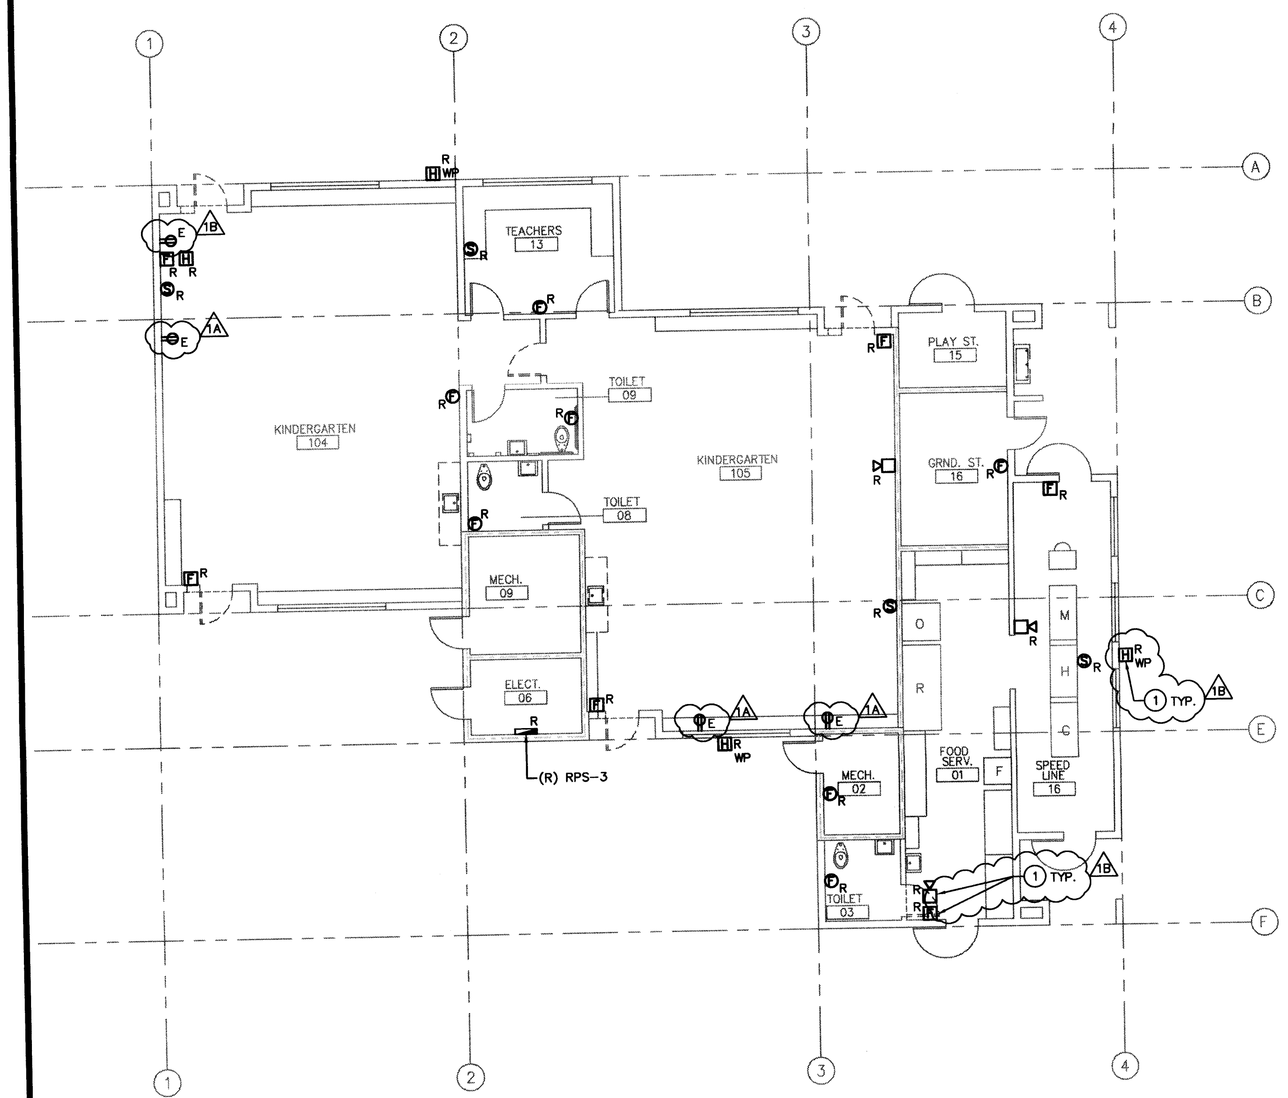

VOICE/DATA & PA SYSTEMS DEMOLITION SCOPE ARE NOT IN CONTRACT 1B

1B

N

BUILDING 3 - POWER & SIGNAL DEMOLITION PLAN 1/8"=1'-0" 1

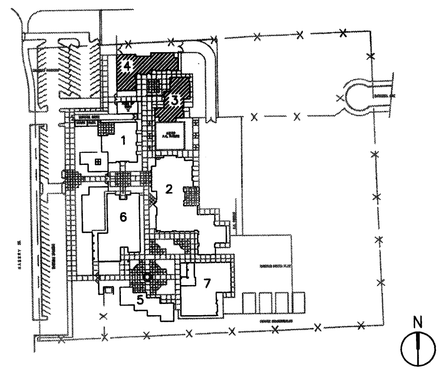

KEY PLAN

2355 Main Street Suite 220
Irvine | CA 92614
949 250 1030
949 955 2706 fax

Architect Seal

LICENSED ARCHITECT GUILLERMO AGUILAR NO. C13165 REN.: MAY. 2013 STATE OF CALIFORNIA

Consultant and Seal

TG
TMDD TAYLOR & GAINES
Suite 400
Ontario, California 91764
Phone: 909.477.6915 Fax: 909.477.6916
www.tgcorp.com

- STRUCTURAL
- MECHANICAL
- ELECTRICAL
- CIVIL

Project No. 2008.125.00

REGISTERED PROFESSIONAL ENGINEER RICHARD ARCHER Lic. E16934 Exp. 6-30-2013 ELECTRICAL STATE OF CALIFORNIA

Agency Approval

IDENTIFICATION STAMP
DIV. OF THE STATE ARCHITECT
APPL. 04-110031
AC ____ FLS ____ SS ____
DATE ____

No.	Date	Revision/Issue
	12/08/08	DSA SUBMITTAL
	02/11/09	DSA SUBMITTAL
	5/11/09	DSA BACKCHECK
1A	12/16/2011	ADDENDUM 1A
1B	01/20/2012	ADDENDUM 1

Project Name

MUIR FUNDAMENTAL SCHOOL MODERNIZATION
1951 MABURY ST.
SANTA ANA, CA 92707

Checked By: RA
Drawn By: JHC

Sheet Title

BUILDING 3 & 4 DEMOLITION PLANS

Sheet Number

ED2.3

Project Number: 10021-010
Scale: AS NOTED

© 2012 gkkworks, All Rights Reserved
NO PART OF THE CONTENTS OF THIS DOCUMENT MAY BE REPRODUCED OR TRANSMITTED IN ANY FORM OR BY ANY MEANS WITHOUT THE WRITTEN PERMISSION OF GKKWORKS.

N:\20.CAD\TTG_Projects\2008\2008-125-00\Muir\ED2-3.dwg 01/19/2012