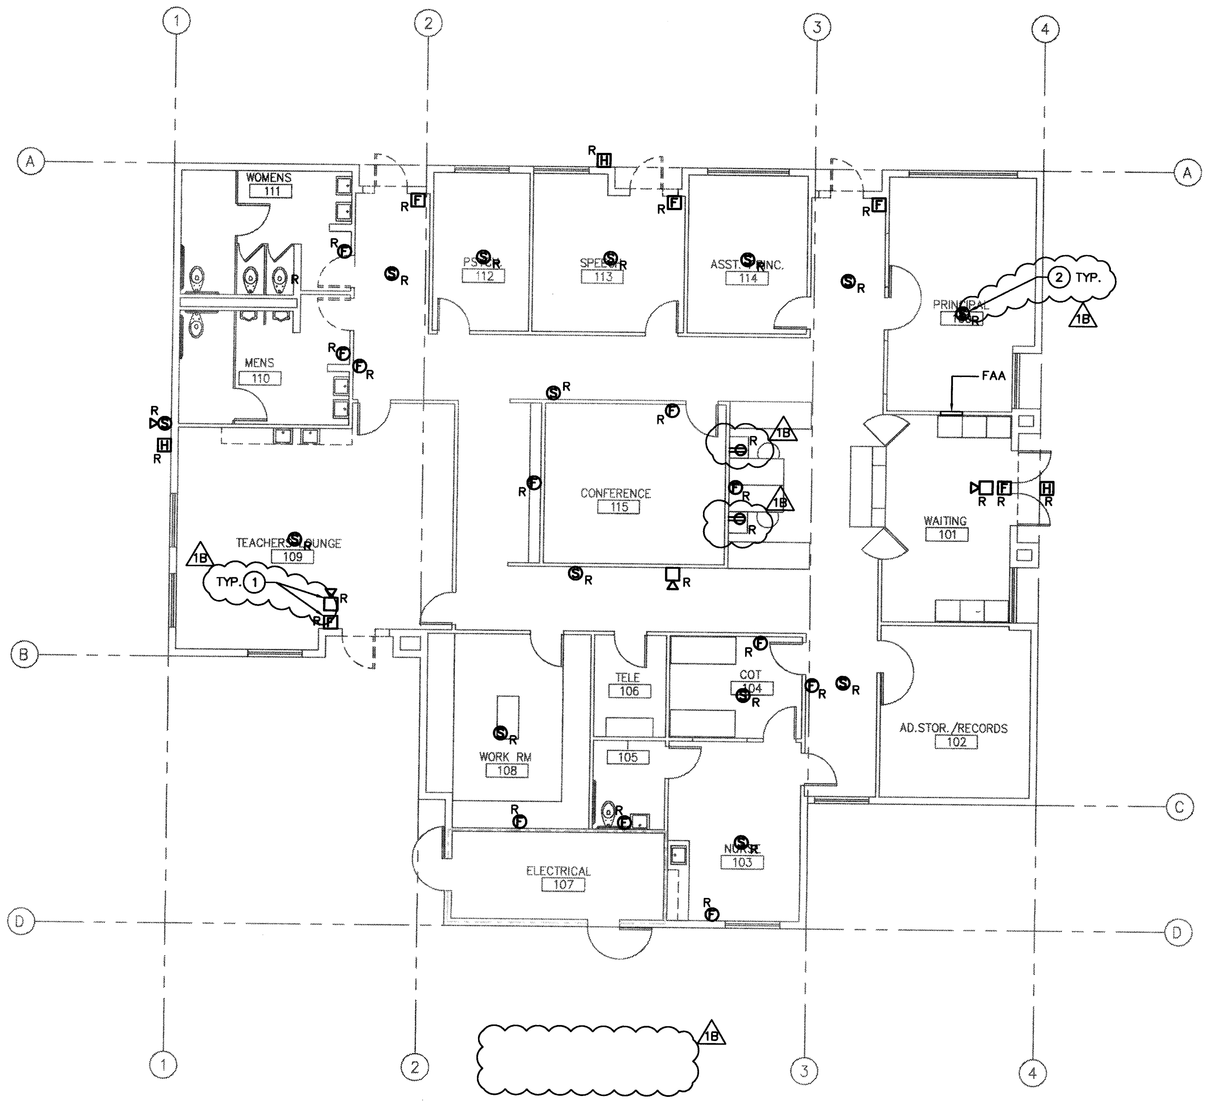

VOICE/DATA & PA SYSTEMS DEMOLITION SCOPE ARE NOT IN CONTRACT

BUILDING 1 - DEMOLITION PLAN

1/8"=1'-0" | 1

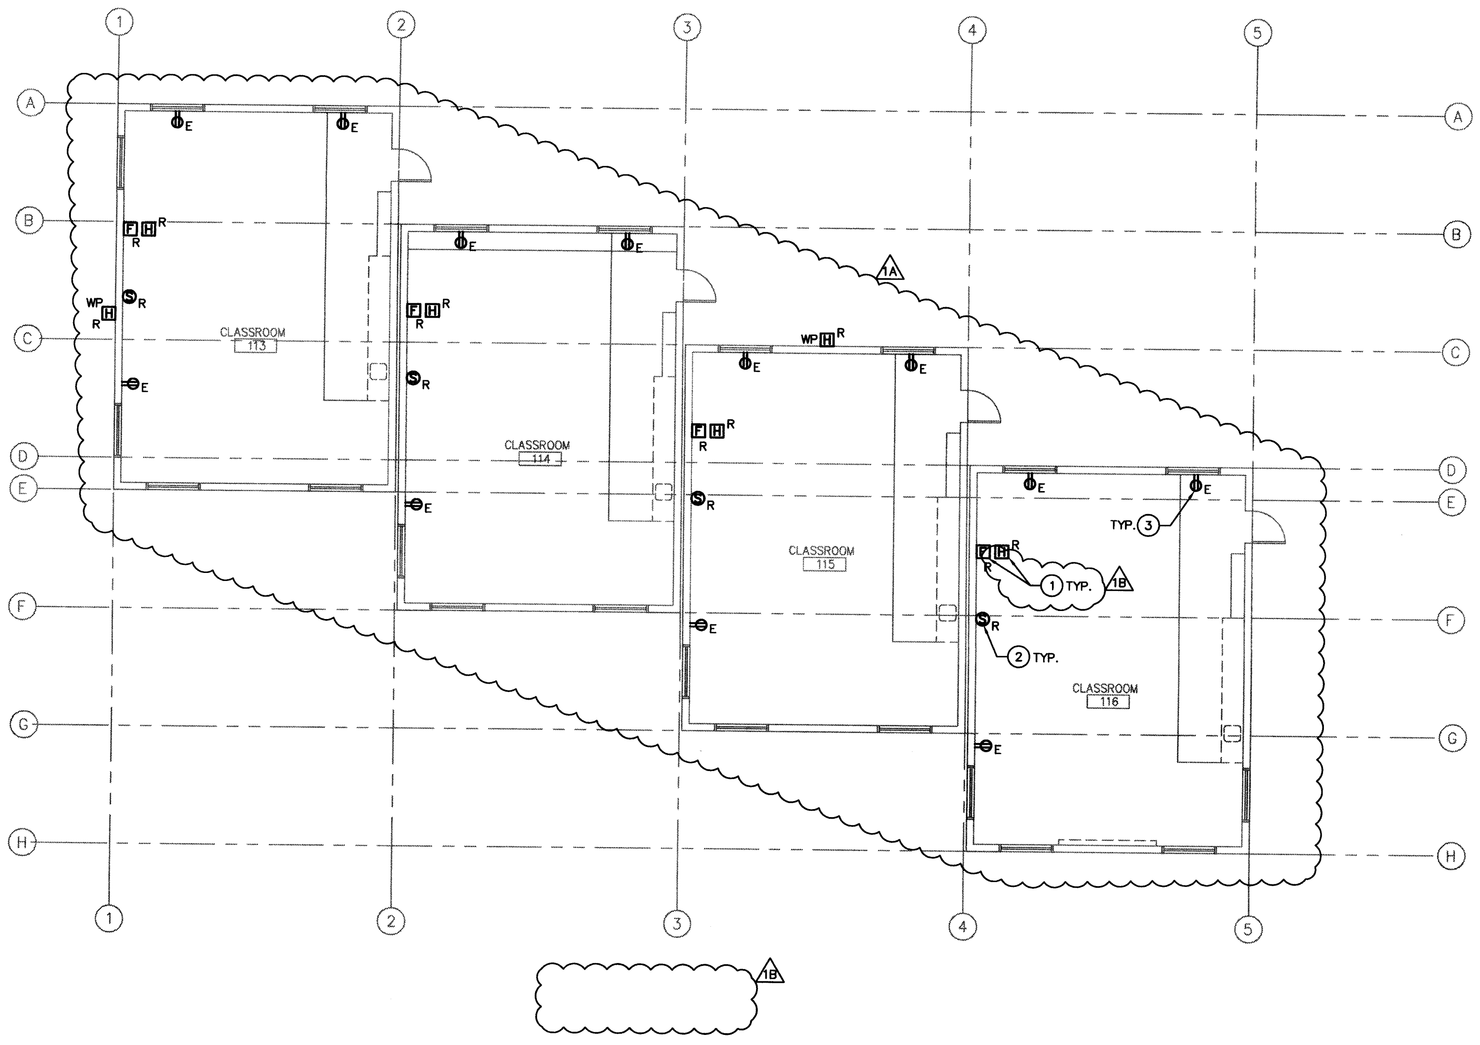

VOICE/DATA & PA SYSTEMS DEMOLITION SCOPE ARE NOT IN CONTRACT

BUILDING 5 - DEMOLITION PLAN

1/8"=1'-0" | 2

KEY NOTES

1. REMOVE FIRE ALARM DEVICES AND WIRING.
2. ~~REMOVE PA SYSTEM SPEAKERS AND WIRING.~~ NIC

KEY NOTES

1. REMOVE FIRE ALARM DEVICES AND WIRING.
2. ~~REMOVE PA SYSTEM SPEAKERS AND WIRING.~~ NIC
3. ~~DUPLEX RECEPTACLES ARE TO BE REMOVED. INTERCONNECT OR SPLICE EXISTING WIRE (BOTH ENDS) FOR CIRCUIT CONTINUITY. PROVIDE/INSTALL ANCHOR, FOR BLANK PLATE COVER.~~ NIC

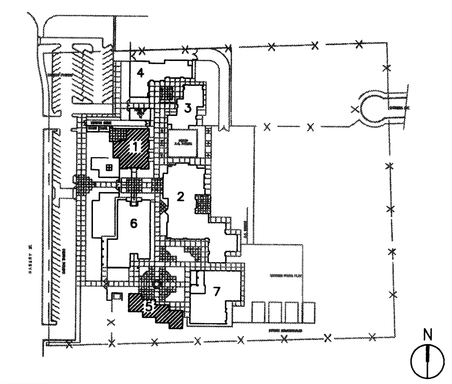

KEY PLAN

SANTA ANA UNIFIED SCHOOL DISTRICT

gkkworks
2355 Main Street Suite 220
Irvine | CA 92614
949 250 1500
949 955 2708 fax

Architect Seal
LICENSED ARCHITECT GUILLERMO AGUILAR NO. C13165 REN.: MAY. 2013 STATE OF CALIFORNIA

Consultant and Seal
TTG • STRUCTURAL • MECHANICAL • ELECTRICAL • CIVIL
TMAD TAYLOR & GAINES
901 Via Piemonte, Suite 400
Ontario, California 91764
Phone: 909.477.6915 Fax: 909.477.6916
www.ttgcorp.com Project No. 2008.125.00
REGISTERED PROFESSIONAL ENGINEER HECTOR C. TORRICO, JR. Lic. E16934 Exp. 6-30-2013 ELECTRICAL STATE OF CALIFORNIA

Agency Approval

IDENTIFICATION STAMP
DIV. OF THE STATE ARCHITECT
APPL. 04-110031
AC _____ FLS _____ SS _____
DATE _____

No.	Date	Revision/Issue
	12/08/08	DSA SUBMITTAL
	02/11/09	DSA SUBMITTAL
	5/11/09	DSA BACKCHECK
1A	12/16/2011	ADDENDUM 1A
1B	01/20/2012	ADDENDUM 1

Project Name
MUIR FUNDAMENTAL SCHOOL MODERNIZATION
1951 MABURY ST.
SANTA ANA, CA 92707

Checked By: RA
Drawn By: KA

Sheet Title
BUILDINGS 1 & 5 DEMOLITION PLANS

Sheet Number
ED2.1

Project Number: 10021-010
Scale: AS NOTED

©2012 gkkworks, All Rights Reserved
NO PART OF THE CONTENTS OF THIS DOCUMENT MAY BE REPRODUCED OR TRANSMITTED IN ANY FORM OR BY ANY MEANS WITHOUT THE WRITTEN PERMISSION OF GKKWORKS.

N:\20CAD\TTG_Projects\2008\2008-125-00\Muir\ED2-1.dwg 01/19/2012