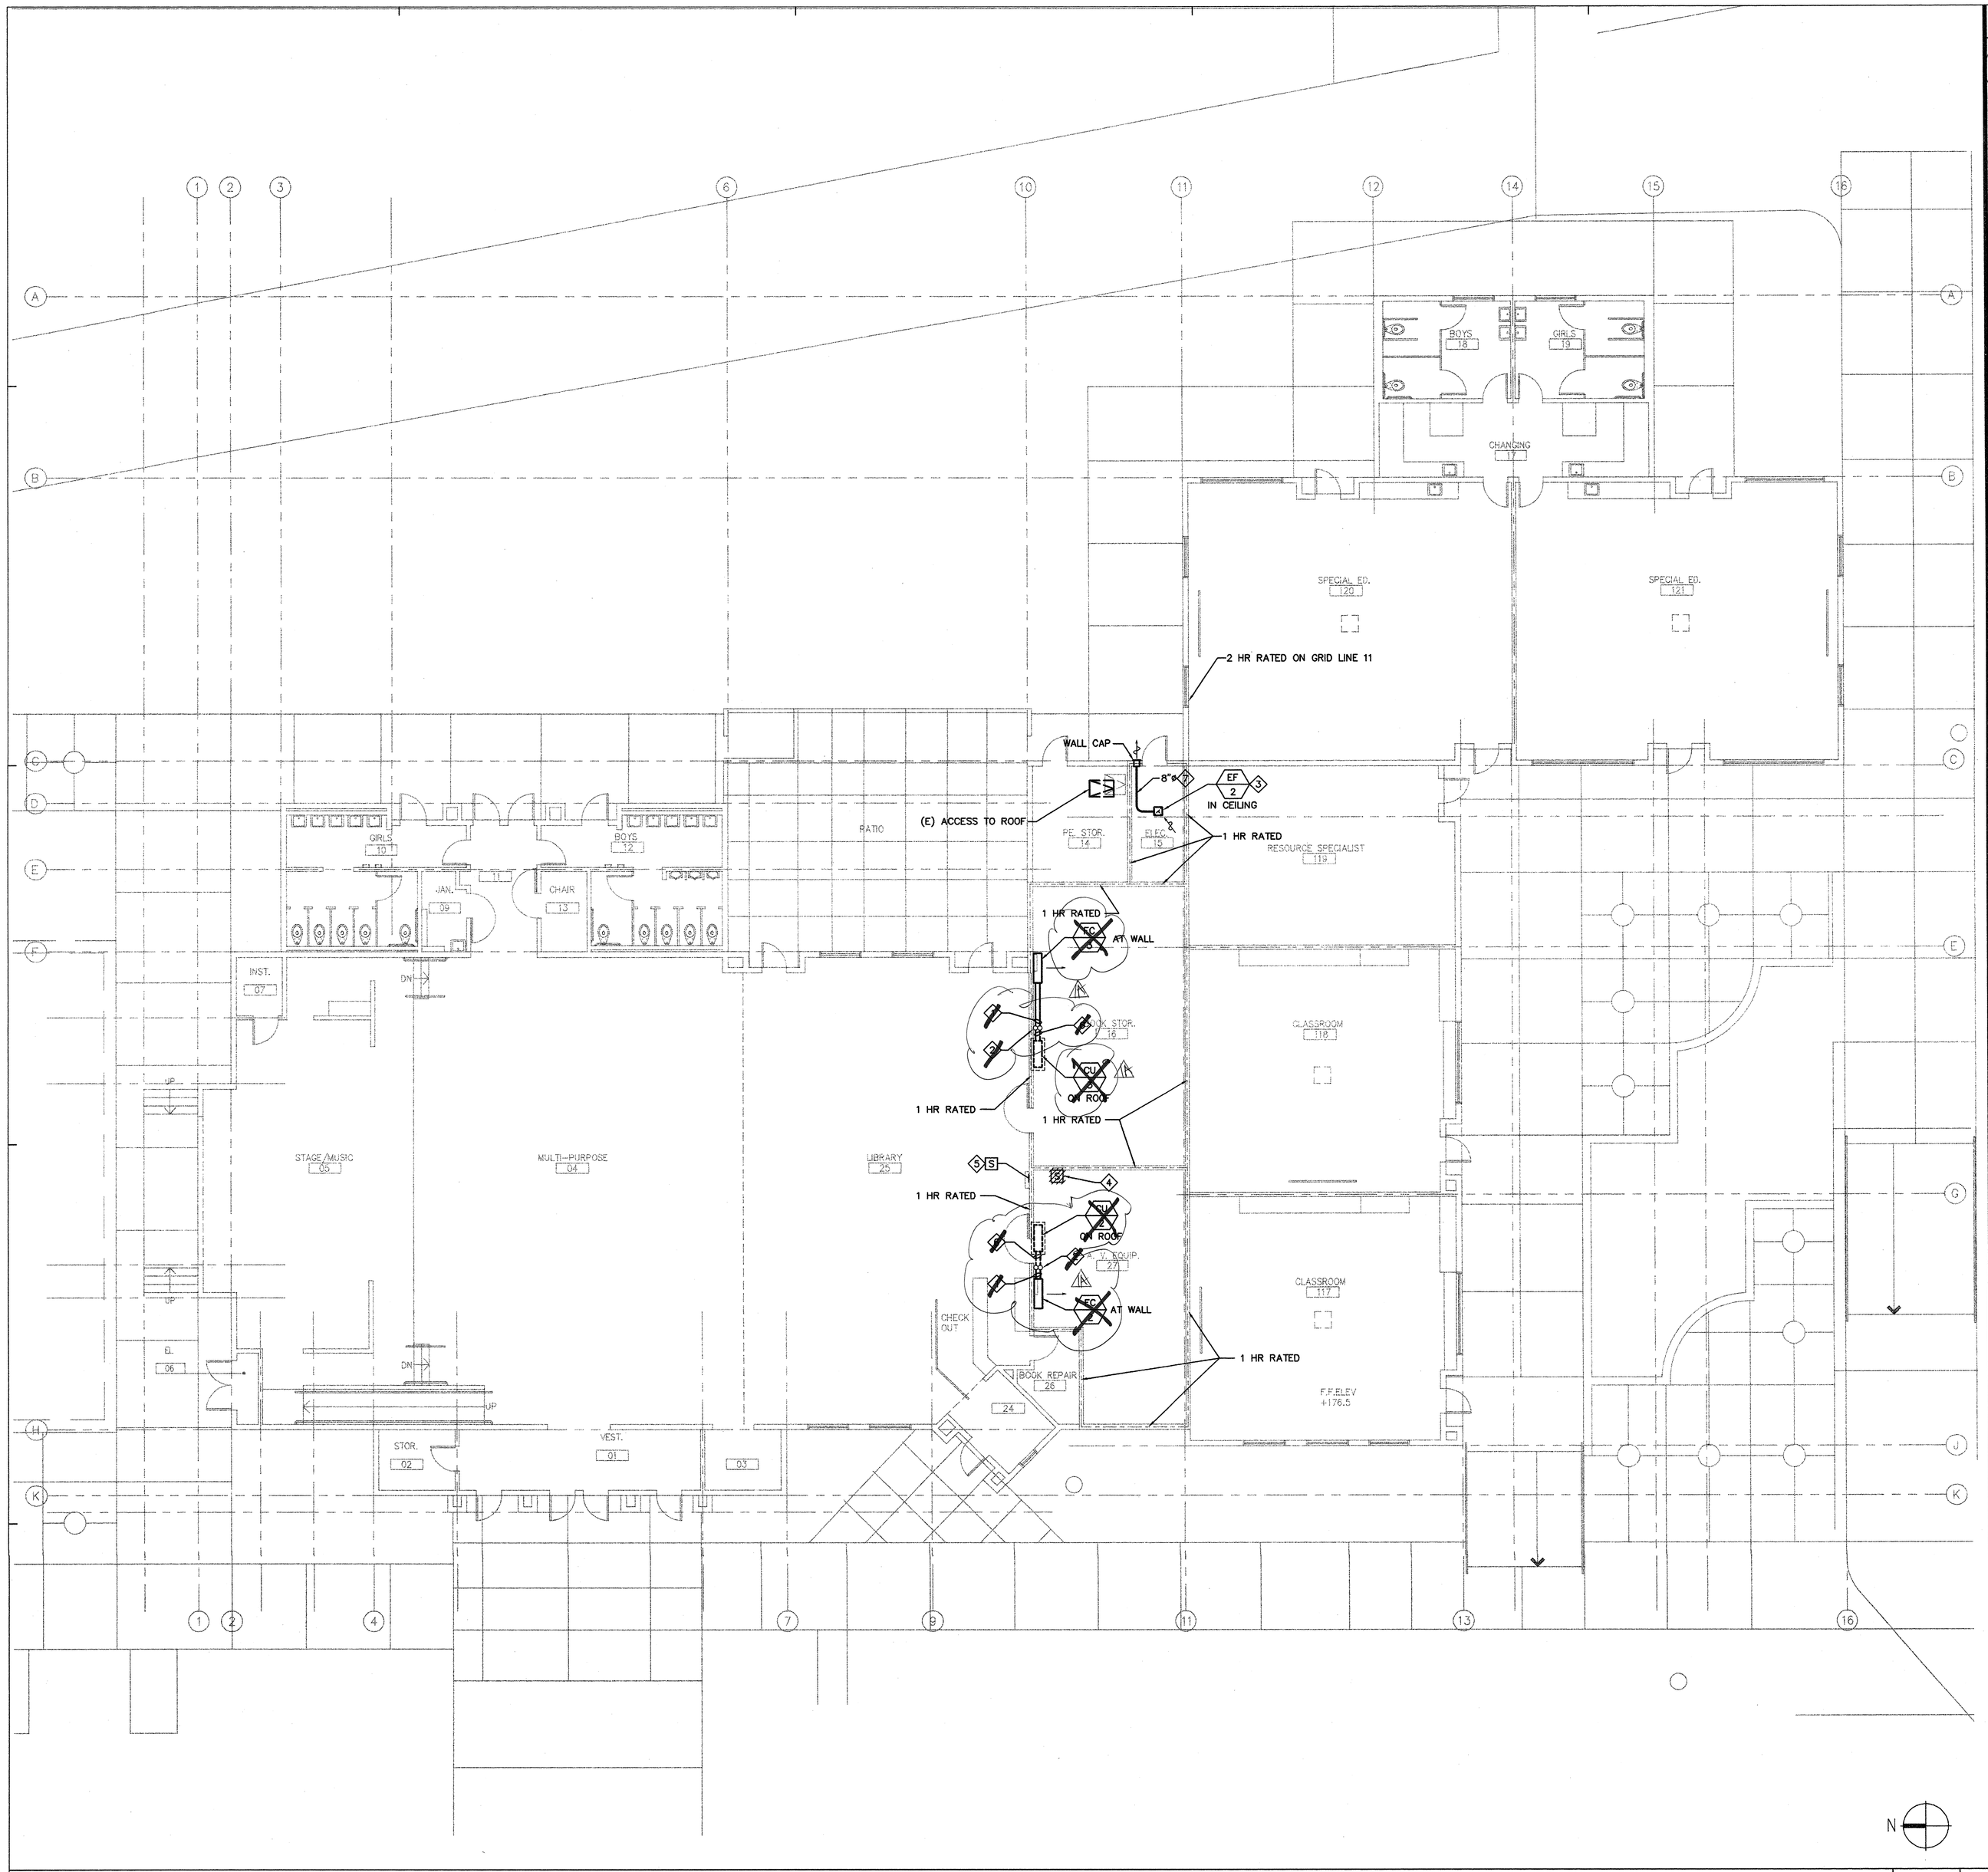

BUILDING 2 REMODEL PLAN

1/8"=1'-0"

2

REMODEL KEY NOTES

1. ~~REFRIGERANT PIPING IN CEILING SPACE. SEE EQUIPMENT SCHEDULES FOR SIZES. SEE 6/M3.0.~~
2. ~~REFRIGERANT PIPING UP TO CONDENSING UNIT ON ROOF. SEE 10/M3.0.~~
3. PATCH AND REPAIR CEILING AS REQUIRED.
4. REMOVE EXISTING SENSOR. PATCH AND REPAIR WALL AS REQUIRED. PROTECT FOR FUTURE USE.
5. NEW LOCATION OF EXISTING SENSOR.
6. ~~REFRIGERANT PIPING ON ROOF. SEE 9/M3.0.~~
7. FOR DUCT SUPPORT DETAIL, SEE 8/M3.0.

REMODEL GENERAL NOTES

1. FOR INDIVIDUAL EQUIPMENT DETAIL REFERENCE, SEE EQUIPMENT SCHEDULES ON SHEET M0.2
2. PATCH AND/OR PAINT EXISTING WALL/FLOOR/ROOF TO MATCH EXISTING MATERIALS AND/OR FINISH WHERE MECHANICAL EQUIPMENT, PIPING, CD/CR, DUCTWORK ARE BEING REMOVED AND/OR REPLACED. COORDINATE WITH OTHER TRADES.
3. FOR CONTROL WIRING DIAGRAMS SEE SHEET M3.1.

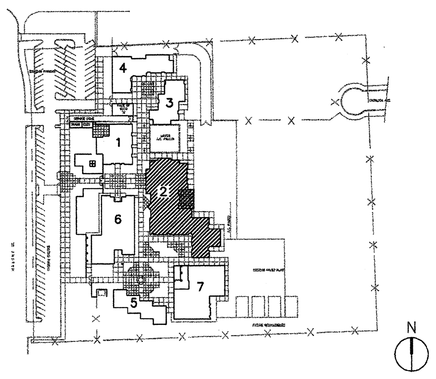

KEY PLAN

SANTA ANA UNIFIED SCHOOL DISTRICT

gkkworks
2355 Main Street Suite 220
Irvine | CA 92614
949 250 1500
949 955 2708 fax

Architect Seal

LICENSED ARCHITECT
GUILLERMO AGUILAR
NO. C13165
REN.: MAY. 2011
STATE OF CALIFORNIA

Consultant and Seal

TMAD TAYLOR & GAINES
• STRUCTURAL
• MECHANICAL
• ELECTRICAL
• CIVIL
800 North Ferrari Lane, Suite 100
Ontario, California 91764
Phone: 909.477.6915 Fax: 909.477.6916
Project No. 2008.125.00

REGISTERED PROFESSIONAL ENGINEER
CURTIS E. RADKE
No. M24519
Exp. 9/30/10
MECHANICAL
STATE OF CALIFORNIA

Agency Approval

IDENTIFICATION STAMP
DIV. OF THE STATE ARCHITECT
APPL. 04-110031
AC / FLS DW SS FLH
DATE NOV 24 2009

No.	Date	Revision/Issue
	12/08/08	DSA SUBMITTAL
	02/11/09	DSA SUBMITTAL
	5/11/09	DSA BACKCHECK
	12/15/2011	BID SET
1A	12-16-2011	ADDENDUM 1A

Project Name

MUIR
FUNDAMENTAL
SCHOOL MODERNIZATION
1951 MABURY ST.
SANTA ANA, CA 92707

Checked By	Drawn By
VR	PR

Sheet Title

BUILDING 2
REMODEL PLAN

Sheet Number

M2.2

Project Number	Scale
10021-010	AS NOTED

© 2009 gkkworks, All Rights Reserved
NO PART OF THE CONTENTS OF THIS DOCUMENT MAY BE REPRODUCED OR TRANSMITTED IN ANY FORM OR BY ANY MEANS WITHOUT THE WRITTEN PERMISSION OF GKKWORKS.

N:\20.CAD\TTG_Projects\2008\2008-125-00\Mpe\M2-2.dwg 11/09/2009