KEY NOTES

NIC

1. ~~REPLACE~~ AND ADJUST MOUNTING HEIGHT OF NON-ADA COMPLAINT DUPLEX RECEPTACLE AND JUNCTION BOX. EXTEND EXISTING CONDUIT TO THE NEW MOUNTING HEIGHT OF DUPLEX RECEPTACLE. MOUNTING HEIGHT OF NEW DUPLEX RECEPTACLE SHALL BE +15" AFF MINIMUM TO BOTTOM LINE OF DUPLEX RECEPTACLE.
2. PROVIDE SURFACE DEVICE BOX AND DEVICE INDICATED. EXTEND DUAL CHANNEL METALLIC SURFACE RACEWAY. ROUTE TO ABOVE CEILING, INSTALL QUANTITY OF CABLES AS INDICATED AND ROUTE CABLES UNSPLICED. REFER TO DETAIL2, SHEET E7.0
3. REPLACE EXISTING STANDARD DUPLEX RECEPTACLE WITH NEW GFI TYPE, +6" ABOVE COUNTER.
4. REPLACE EXISTING DUPLEX RECEPTACLE WITH NEW.
5. PROVIDE/INSTALL DUPLEX RECEPTACLE FOR PROJECTOR MOUNTED ON CEILING. VERIFY EXACT LOCATION OF PROJECTOR IN THE FIELD.
6. RECEPTACLE MOUNTED ON "IDF" BACK WALL.
7. PANELBOARD MOUNTING DATAIL, REFER TO DETAIL 4, SHEET E7.1.
8. 1-HOUR FIRE RATED WALL, REFER TO DETAIL 2, SHEET E7.1.

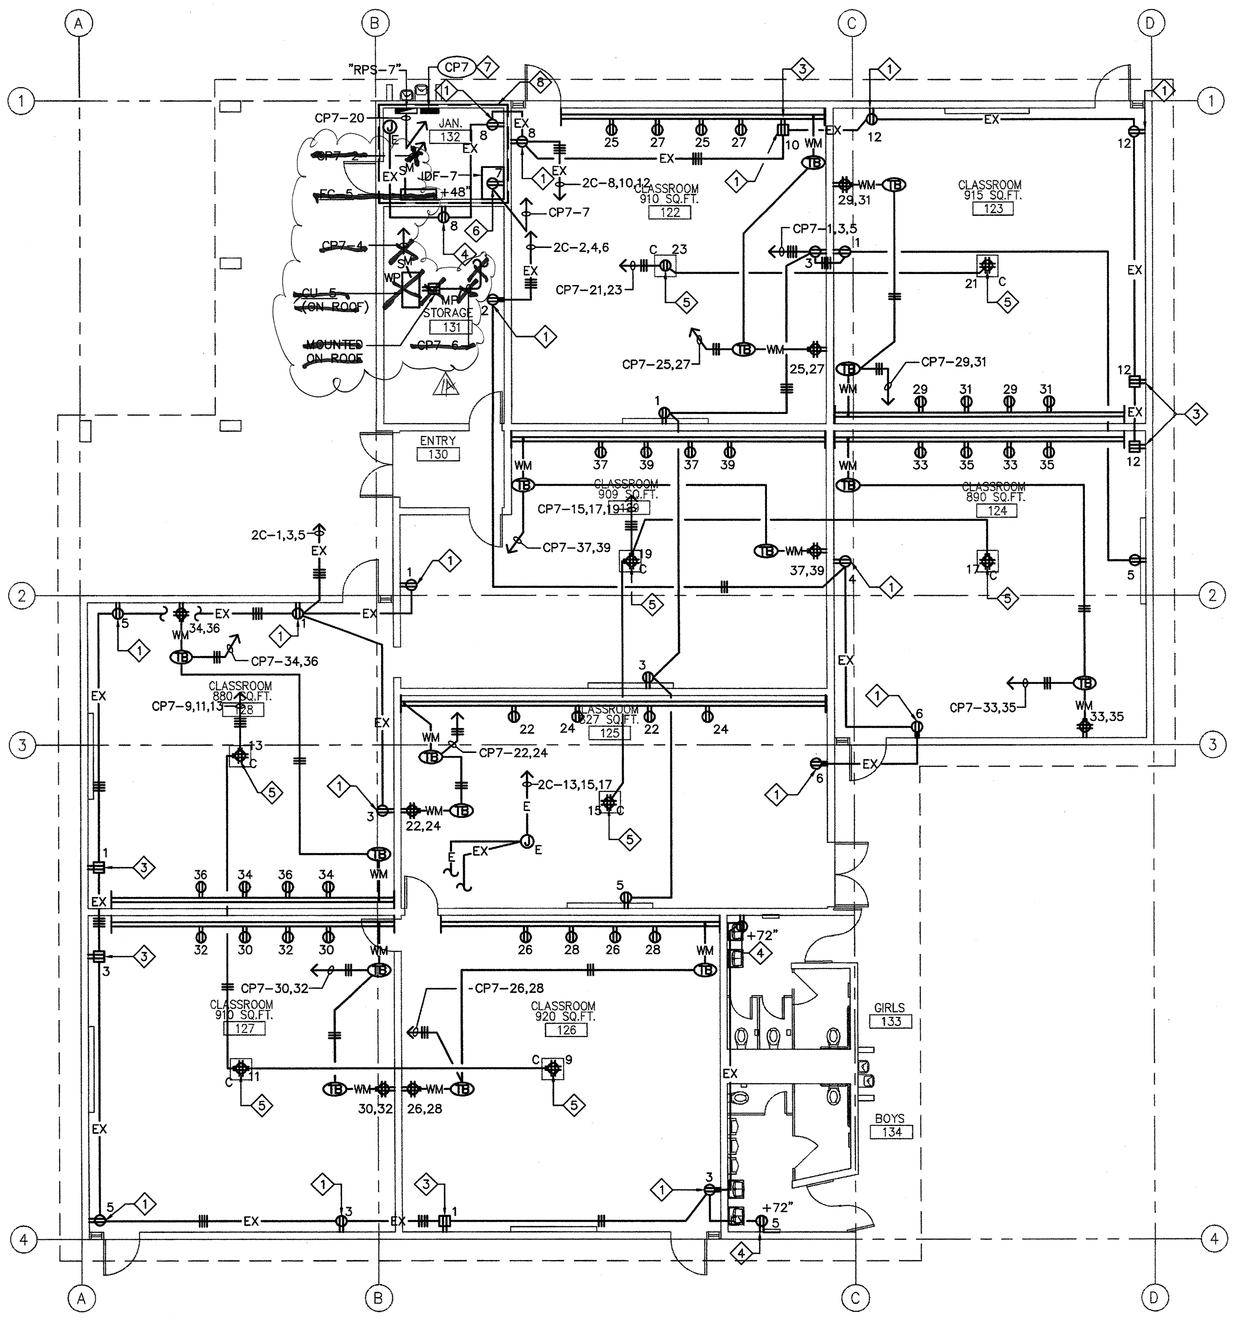

SEE NOTE 2

BUILDING 7 - POWER PLAN 1/8"=1'-0" 2

KEY NOTES

NIC

1. ~~REPLACE~~ AND ADJUST MOUNTING HEIGHT OF NON-ADA COMPLAINT DUPLEX RECEPTACLE AND JUNCTION BOX. EXTEND EXISTING CONDUIT TO THE NEW MOUNTING HEIGHT OF DUPLEX RECEPTACLE. MOUNTING HEIGHT OF NEW DUPLEX RECEPTACLE SHALL BE +15" AFF MINIMUM TO BOTTOM LINE OF DUPLEX RECEPTACLE.
2. PROVIDE SURFACE DEVICE BOX AND DEVICE INDICATED. EXTEND DUAL CHANNEL METALLIC SURFACE RACEWAY. ROUTE TO ABOVE CEILING, INSTALL QUANTITY OF CABLES AS INDICATED AND ROUTE CABLES UNSPLICED. REFER TO DETAIL2, SHEET E7.0
3. REPLACE EXISTING STANDARD DUPLEX RECEPTACLE WITH NEW GFI TYPE, +6" ABOVE COUNTER.
4. REPLACE EXISTING DUPLEX RECEPTACLE WITH NEW.
5. PROVIDE/INSTALL DUPLEX RECEPTACLE FOR PROJECTOR MOUNTED ON CEILING. VERIFY EXACT LOCATION OF PROJECTOR IN THE FIELD.
6. RECEPTACLE MOUNTED ON "IDF" BACK WALL.
7. PANELBOARD MOUNTING DATAIL, REFER TO DETAIL 4, SHEET E7.1.
8. 1-HOUR FIRE RATED WALL, REFER TO DETAIL 2, SHEET E7.1.

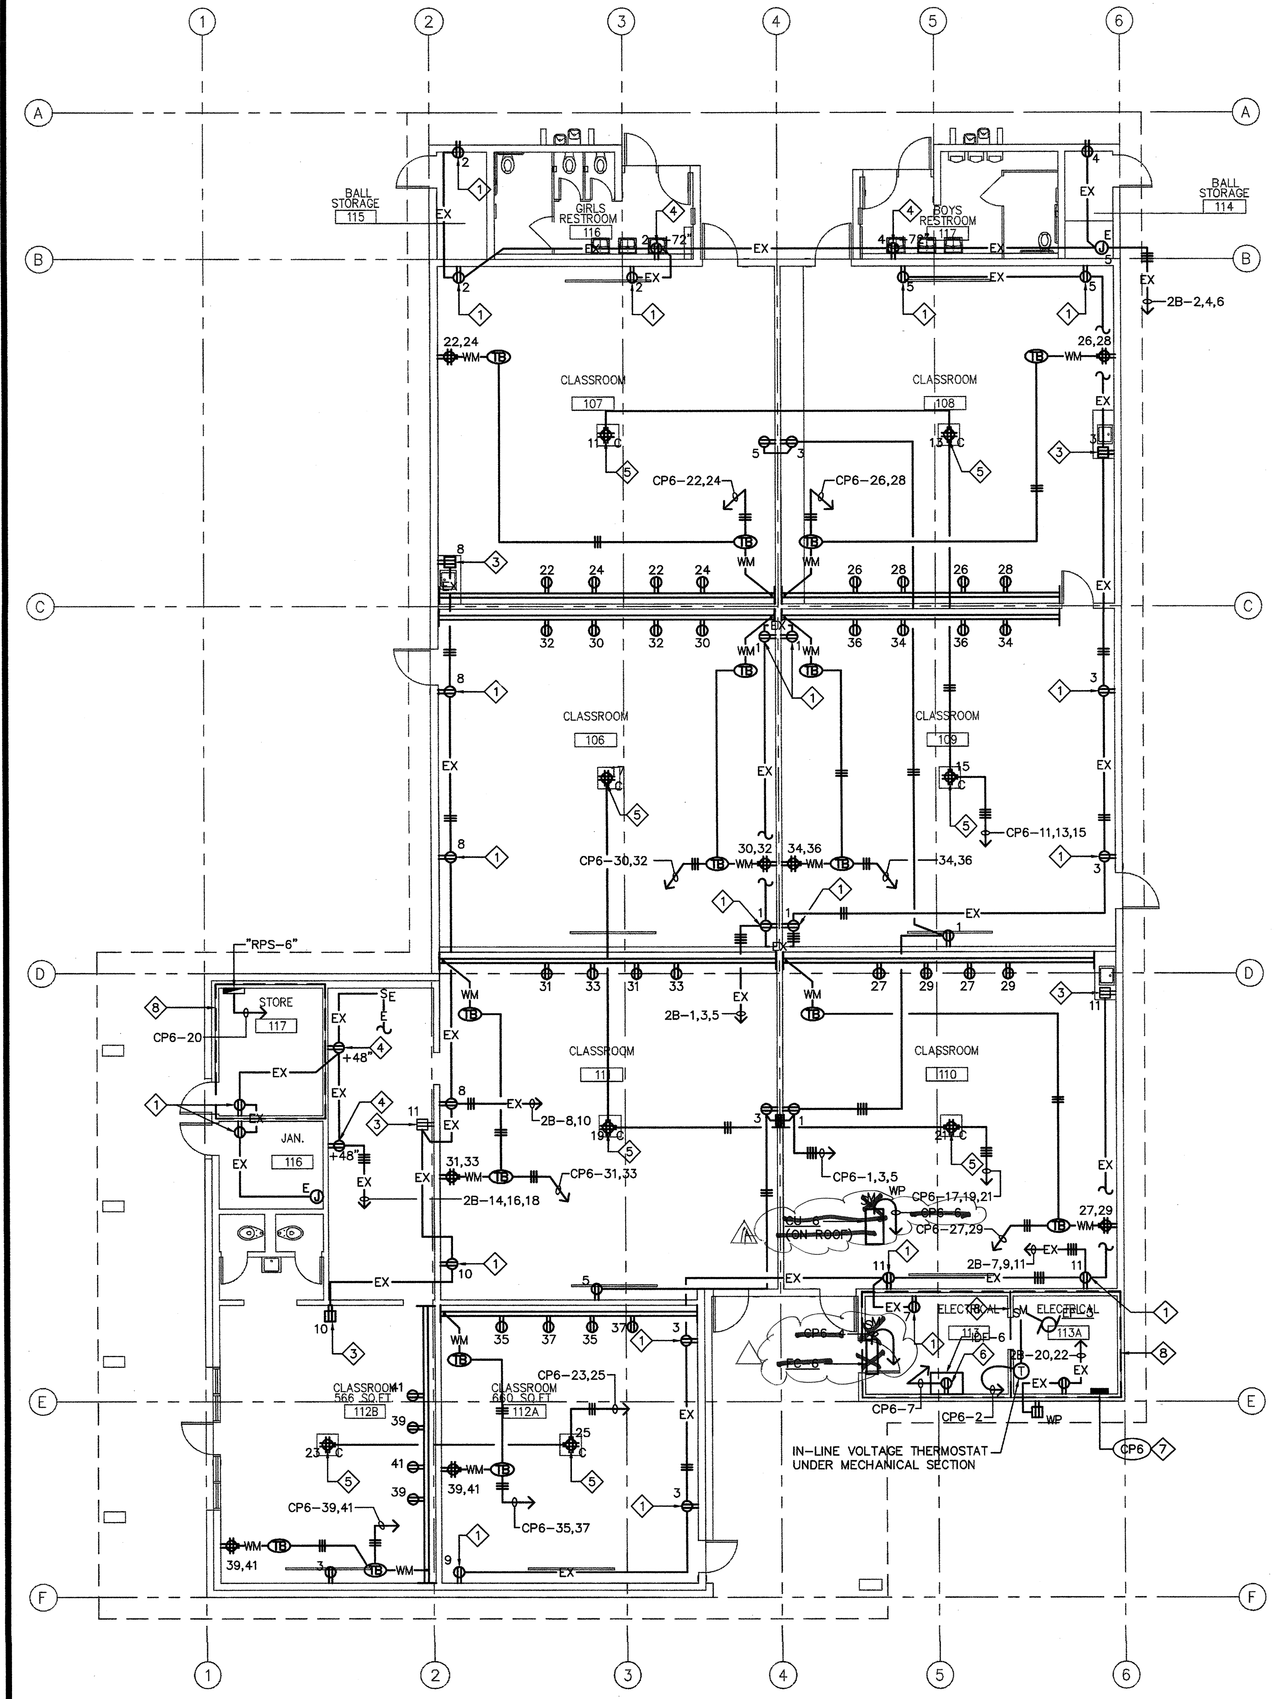

SEE NOTE 2

BUILDING 6 - POWER PLAN 1/8"=1'-0" 1

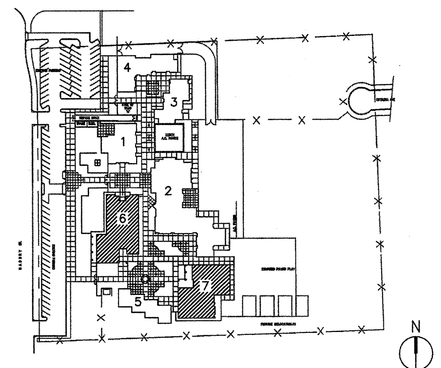

KEY PLAN

gkkworks
2355 Main Street Suite 220
Irvine | CA 92614
949 250 1500
949 955 2708 fax

Architect Seal

LICENSED ARCHITECT GUILLERMO AGUILAR NO. C13165 REN.: MAY. 2011 STATE OF CALIFORNIA

Consultant and Seal

TMAD TAYLOR & GAINES
- STRUCTURAL
- MECHANICAL
- ELECTRICAL
- CIVIL

800 North Ferrari Lane, Suite 100
Ontario, California 91764
Phone: 909.477.6915 Fax: 909.477.6916
Project No. 2008.125.00

REGISTERED PROFESSIONAL ENGINEER RAYMOND C. IGNACIO Lic. E16934 Exp. 6-30-2011 ELECTRICAL STATE OF CALIFORNIA

Agency Approval

IDENTIFICATION STAMP
DIV. OF THE STATE ARCHITECT
APPL. 04-110031
AC FLS SS
DATE NOV 24 2009

No.	Date	Revision/Issue
	12/08/08	DSA SUBMITTAL
	02/11/09	DSA SUBMITTAL
	5/11/09	DSA BACKCHECK
	12/15/2011	BID SET
1	12-16-2011	ADDENDUM 1A

Project Name

MUIR FUNDAMENTAL SCHOOL MODERNIZATION
1951 MABURY ST.
SANTA ANA, CA 92707

Checked By: RA
Drawn By: JH/JHC

Sheet Title

BUILDINGS 6 & 7 POWER PLANS

Sheet Number

E3.4

Project Number: 10021-010-00
Scale: AS NOTED

© 2009 gkkworks, All Rights Reserved
NO PART OF THE CONTENTS OF THIS DOCUMENT MAY BE REPRODUCED OR TRANSMITTED IN ANY FORM OR BY ANY MEANS WITHOUT THE WRITTEN PERMISSION OF GKKWORKS.

N:\20.CAD\TTG_Projects\2008\2008-125-00\Mpe\E3-4.dwg 10/02/2009