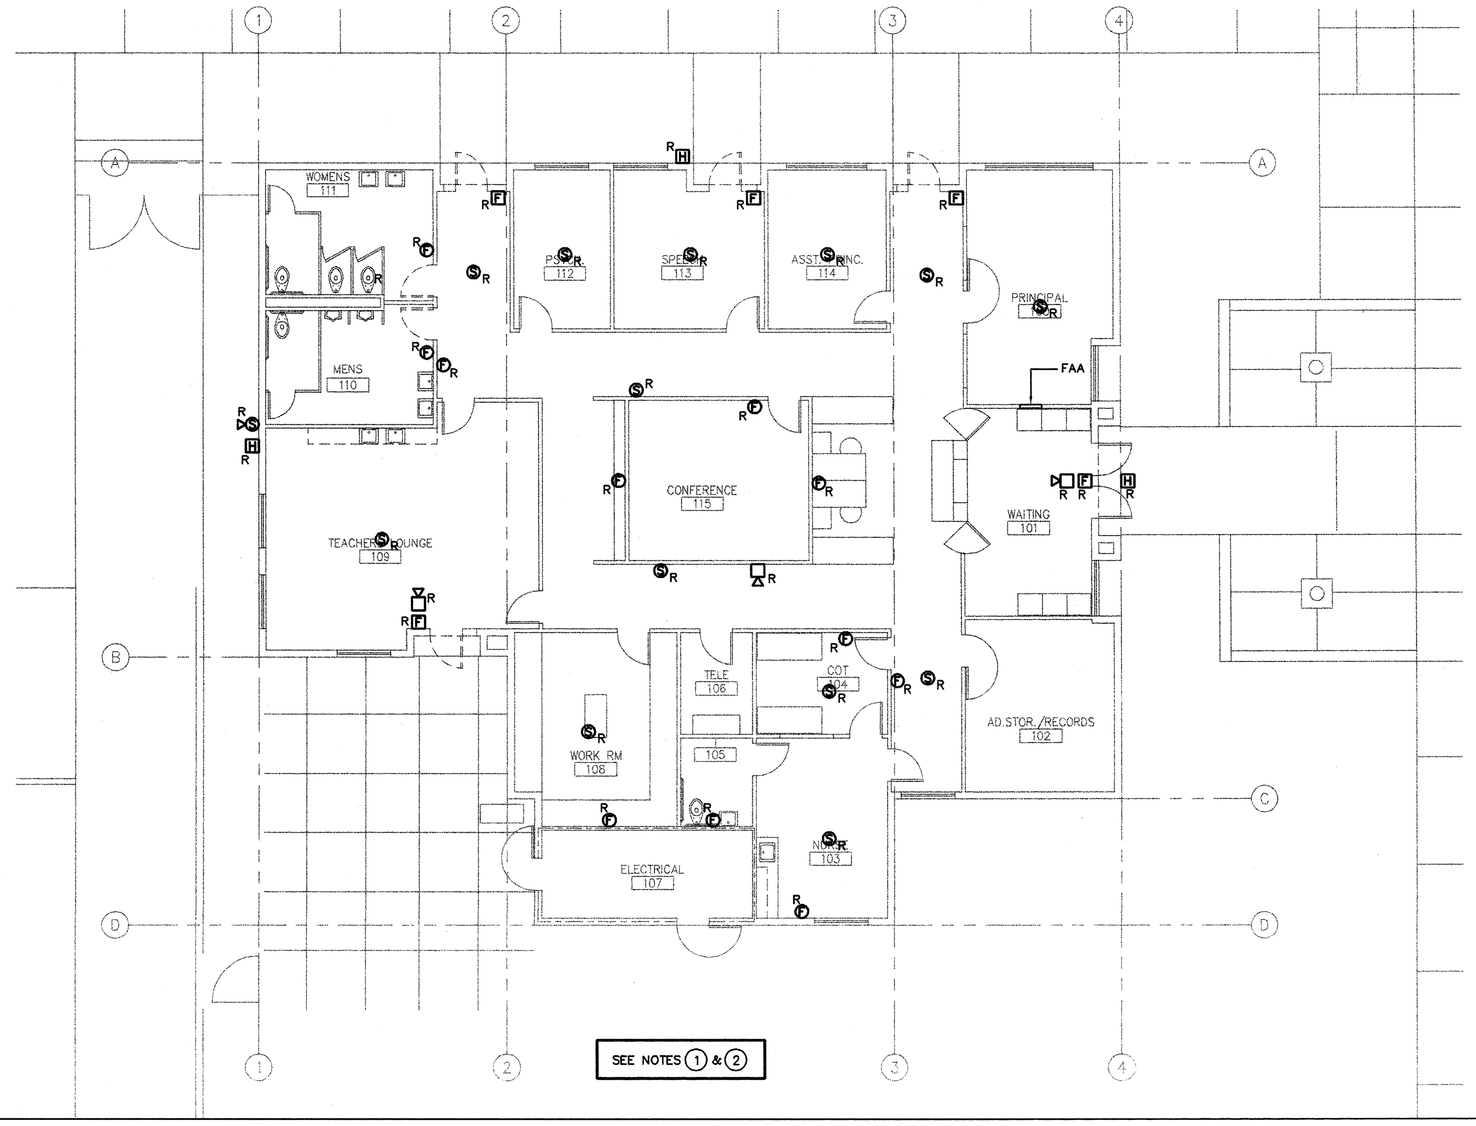

BUILDING 1 - DEMOLITION PLAN

1/8"=1'-0" | 1

KEY NOTES

1. REMOVE FIRE ALARM PULL STATION AND WIRING.
2. ~~REMOVE PA SYSTEM SPEAKERS AND WIRING.~~ NIC

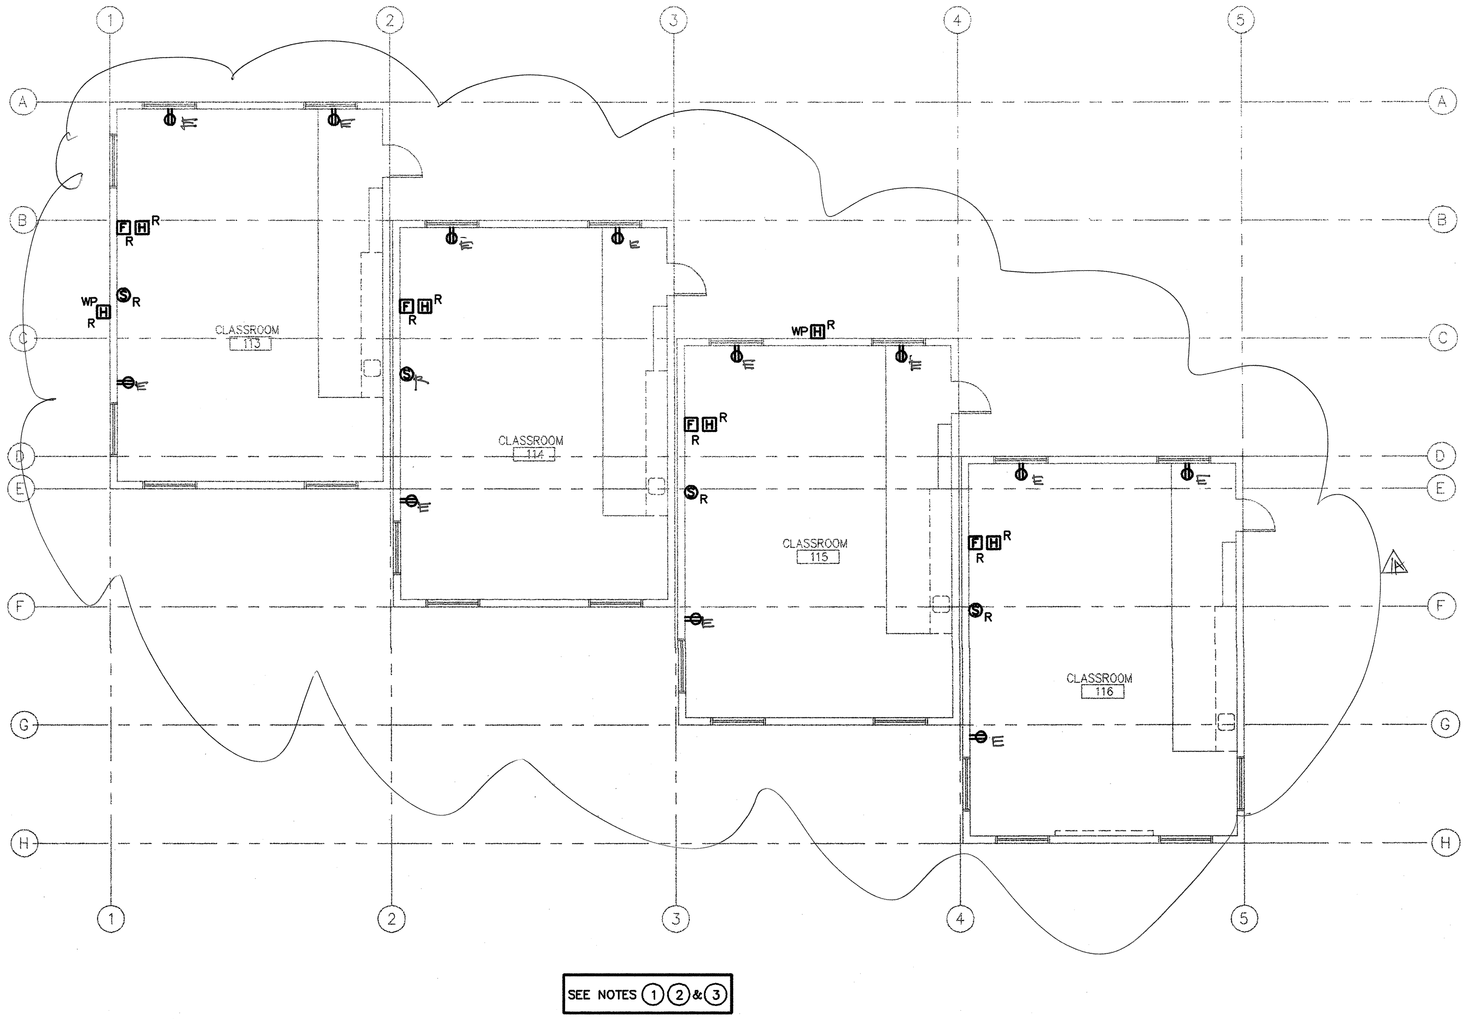

BUILDING 5 - DEMOLITION PLAN

1/8"=1'-0" | 2

KEY NOTES

1. REMOVE FIRE ALARM PULL STATION AND WIRING.
2. ~~REMOVE PA SYSTEM SPEAKERS AND WIRING.~~ NIC
3. DUPLEX RECEPTACLES ARE TO BE REMOVED. INTERCONNECT OR SPLICE EXISTING WIRE FOR CIRCUIT CONTINUITY. PROVIDE/INSTALL JUNCTION BOX BLANK PLATE COVER.

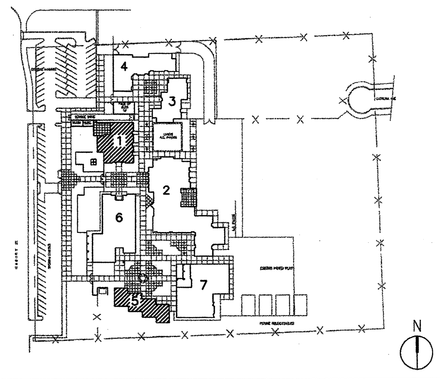

KEY PLAN

SANTA ANA UNIFIED SCHOOL DISTRICT

gkkworks
2355 Main Street Suite 220
Irvine | CA 92614
949 250 1500
949 955 2708 fax

Architect Seal

LICENSED ARCHITECT GUILLERMO AGUILAR NO. C13165 REN.: MAY. 2011 STATE OF CALIFORNIA

Consultant and Seal

TMAD TAYLOR & GAINES
• STRUCTURAL • MECHANICAL • ELECTRICAL • CIVIL
800 North Ferrari Lane, Suite 100
Ontario, California 91764
Phone: 909.477.6915 Fax: 909.477.6916
Project No. 2008.125.00

REGISTERED PROFESSIONAL ENGINEER GEORGE C. IGNACIO, JR. Lic. E16934 Exp. 6-30-2011 ELECTRICAL STATE OF CALIFORNIA

Agency Approval

IDENTIFICATION STAMP
DIV. OF THE STATE ARCHITECT
APPL. 04-110031
AC ____ DLS ____ SS KH
DATE NOV 24 2009

No.	Date	Revision/Issue
	12/08/08	DSA SUBMITTAL
	02/11/09	DSA SUBMITTAL
	5/11/09	DSA BACKCHECK
	12/15/2011	BID SET
1A	12.16.2011	ADDENDUM 1A

Project Name

MUIR FUNDAMENTAL SCHOOL MODERNIZATION
1951 MABURY ST.
SANTA ANA, CA 92707

Checked By: RA
Drawn By: KA

Sheet Title

BUILDINGS 1 & 5 DEMOLITION PLANS

Sheet Number

ED2.1

Project Number: 10021-010
Scale: AS NOTED

© 2009 gkkworks, All Rights Reserved
NO PART OF THE CONTENTS OF THIS DOCUMENT MAY BE REPRODUCED OR TRANSMITTED IN ANY FORM OR BY ANY MEANS WITHOUT THE WRITTEN PERMISSION OF GKKWORKS.

N:\20.CAD\TIG_Projects\2008\2008-125-00\Wpe\ED2-1.dwg 11/13/2009